


Key Plan

**TOTAL SF AVAILABLE - 8,764 SF**

OFFICE - 0,000 SF

WAREHOUSE - 8,764 SF

[Click to access 3D model](#)

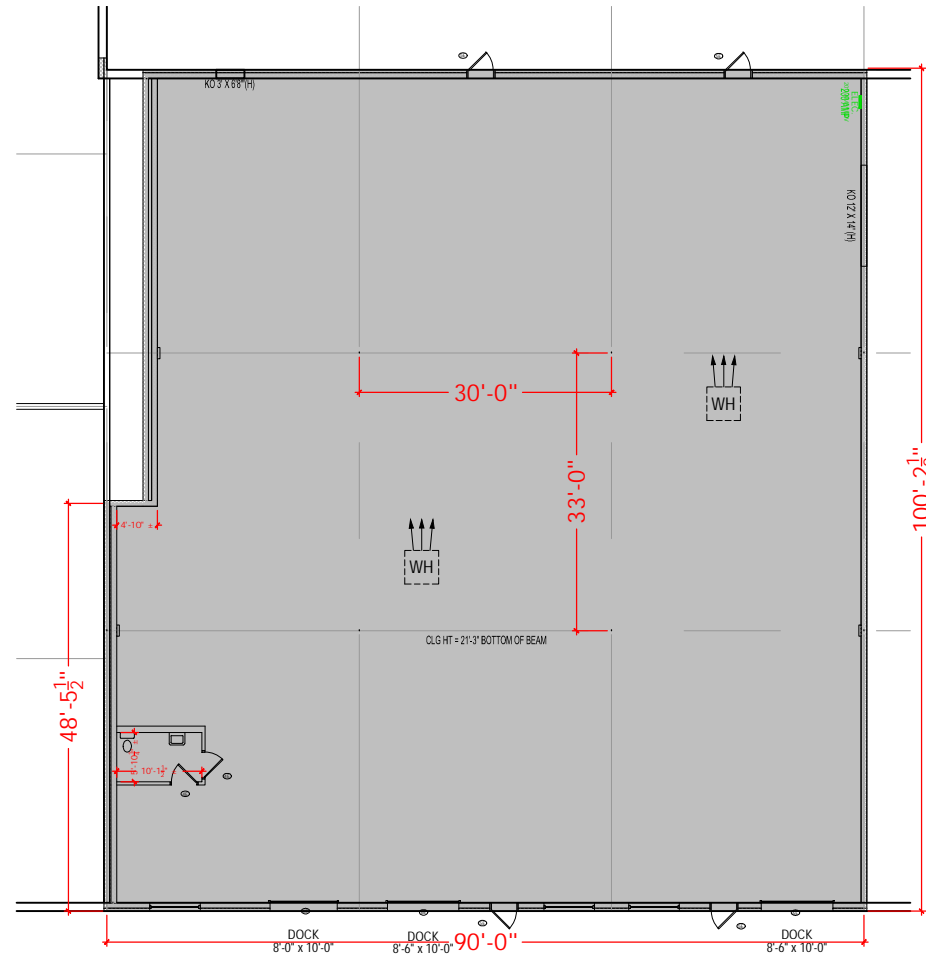

Floor Plan