
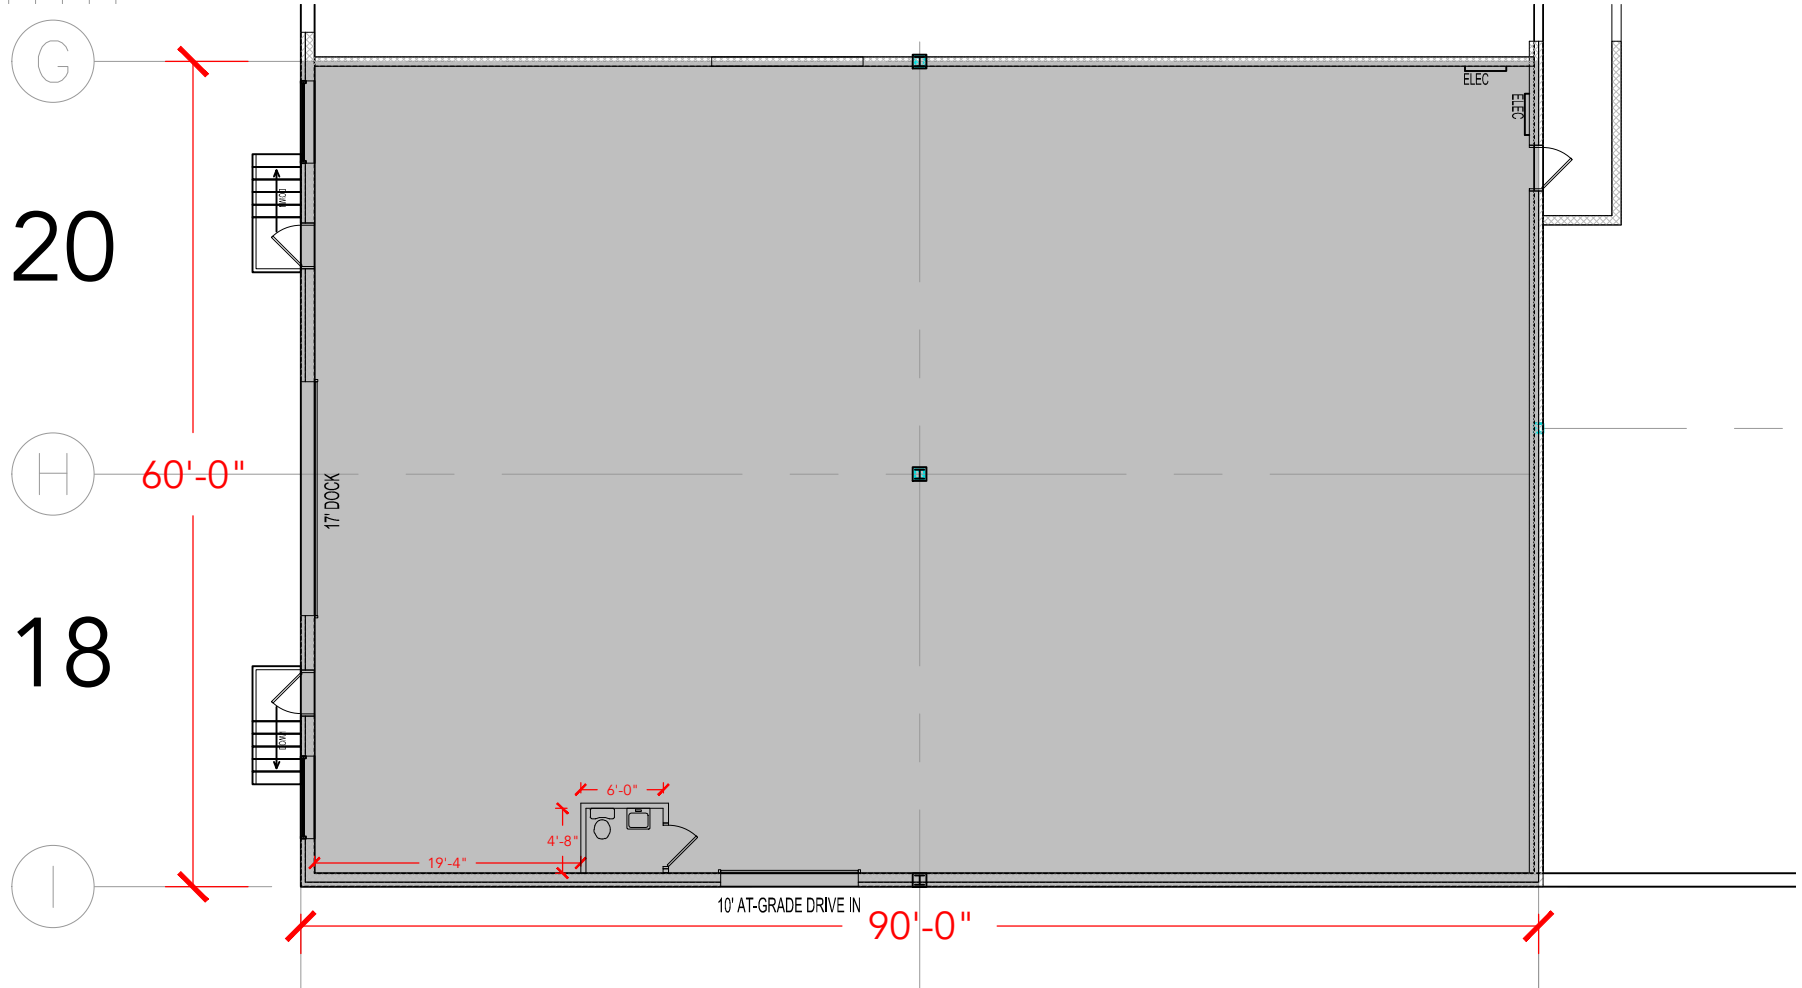


TOTAL SF AVAILABLE - 5,400 SF

OFFICE - 0,000 SF

WAREHOUSE SF - 5,400 SF

[Click to access 3D model](#)

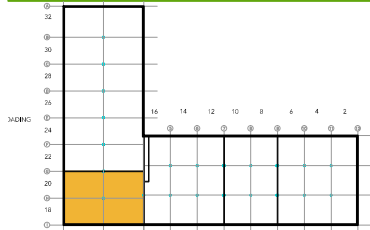

Floor Plan