


**TOTAL SF AVAILABLE - 9,000 SF**

OFFICE - 0,000 SF

WAREHOUSE - 9,000 SF


[Click to access CADD file](#)

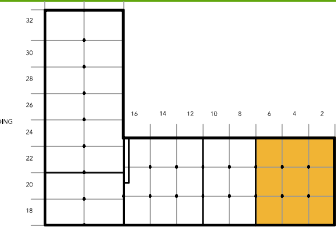

Key Plan

## Floor Plan

PLAN NOT TO SCALE - THIS IS NOT A CONSTRUCTION DOCUMENT

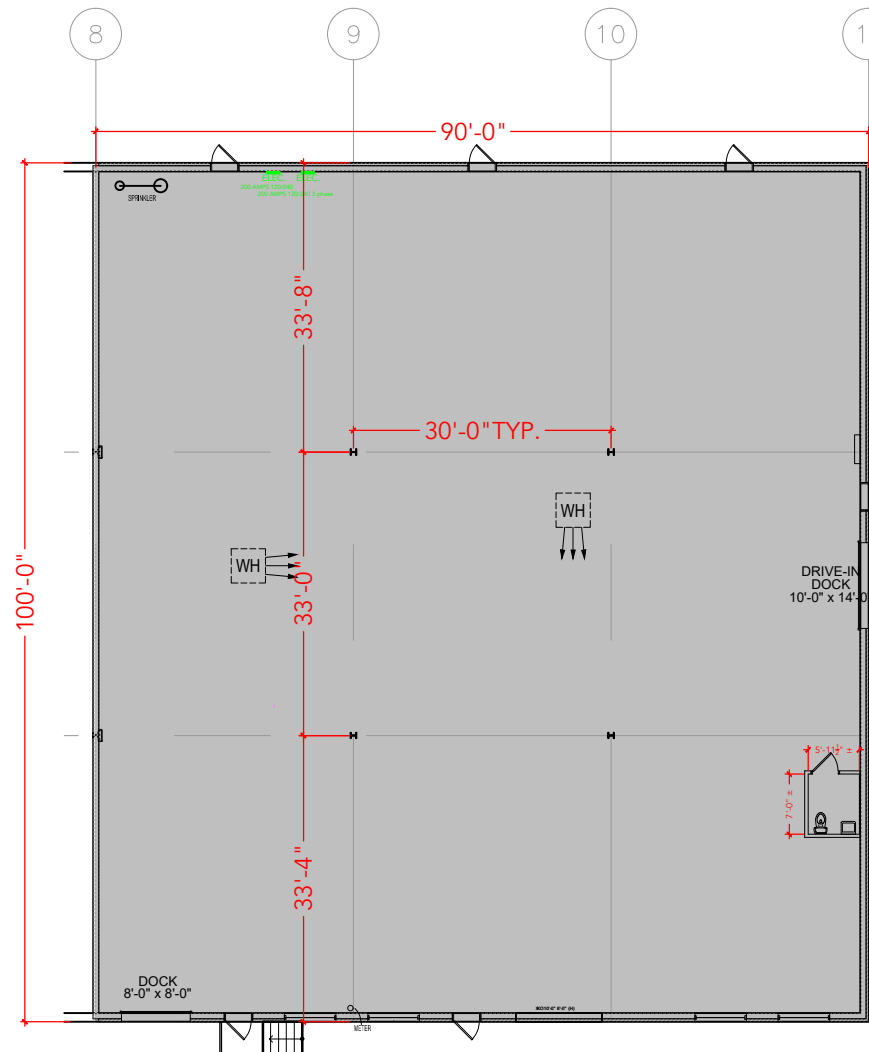

DRAWING #: 001-2-6

ASBUILT DATE: 12.19.22