


TOTAL SF AVAILABLE -5,850 SF


OFFICE - 307 SF

WAREHOUSE - 5,543 SF

[Click to access CADD file](#)

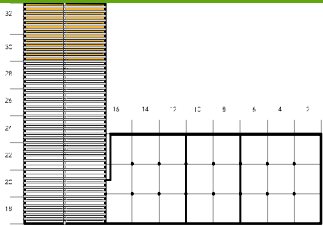

Key Plan

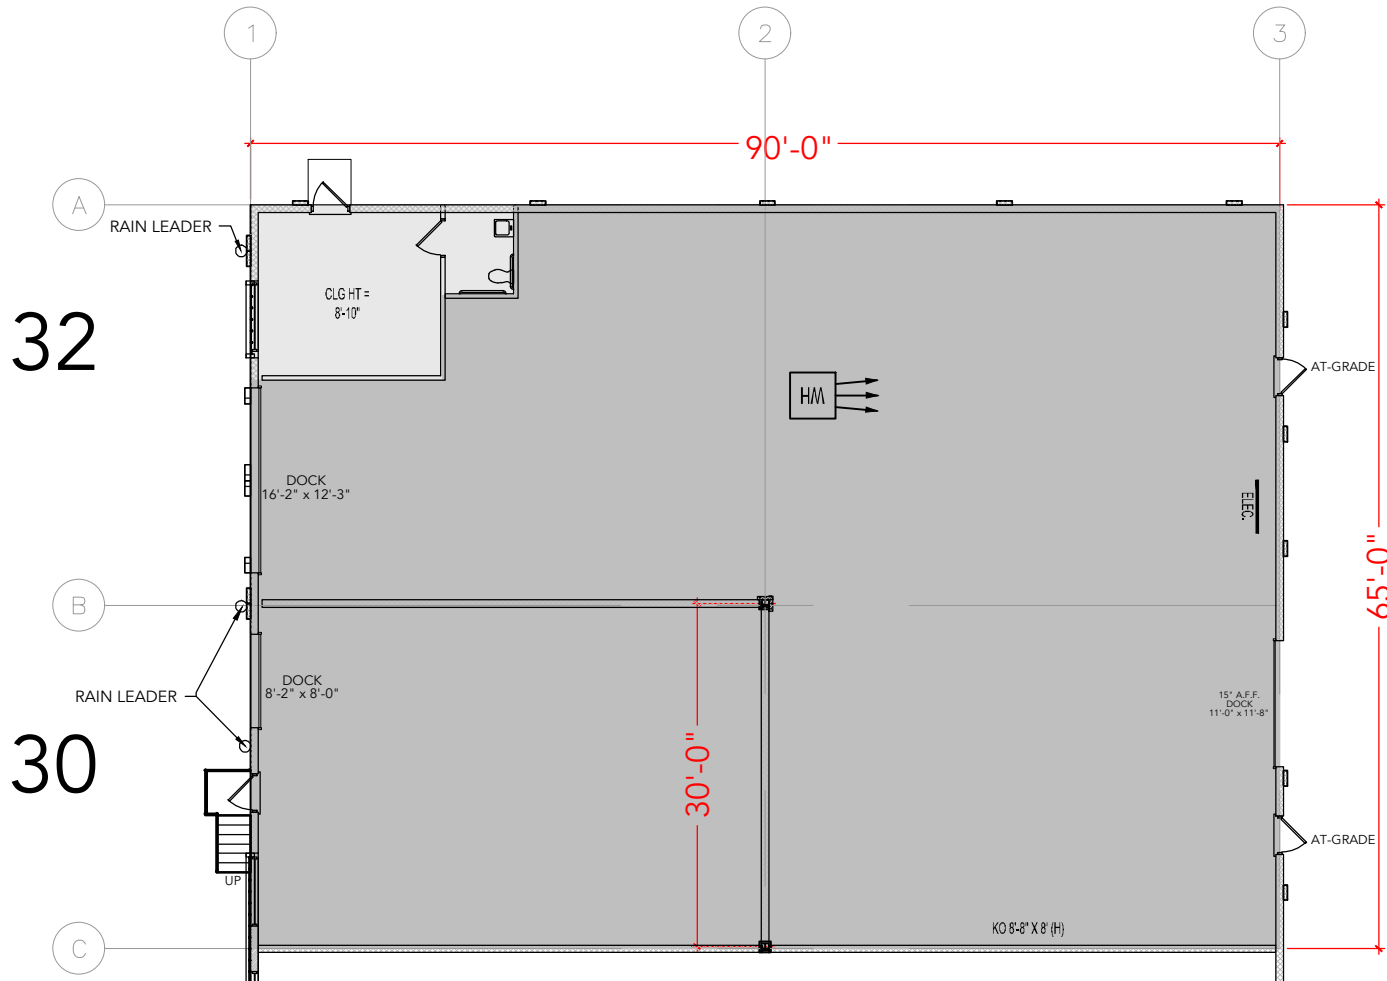

Floor Plan