


TOTAL SF AVAILABLE -8,422 SF


OFFICE - 5,893 SF

WAREHOUSE SF - 2,529 SF

[Click to access 3D model](#)

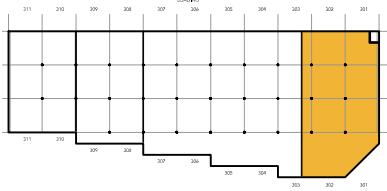

Key Plan

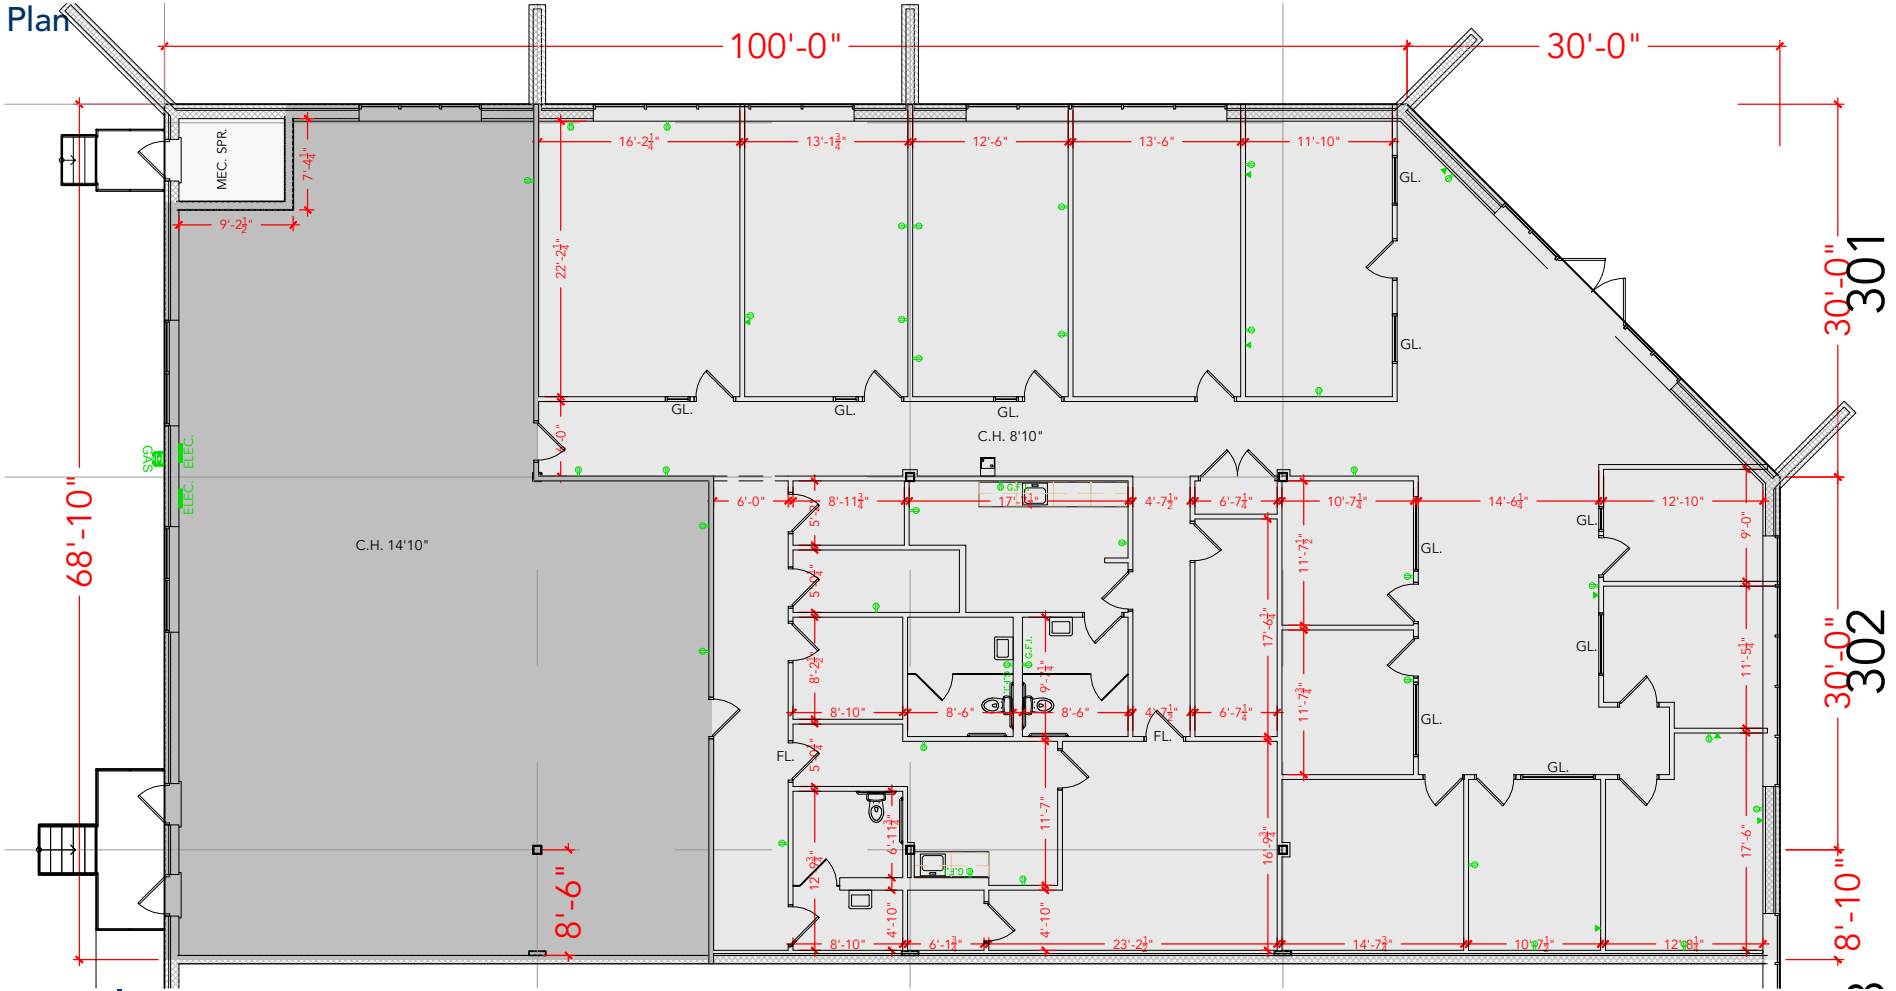

Floor Plan