


TOTAL SF AVAILABLE - 6,352 SF


OFFICE - 892 SF

WAREHOUSE SF - 5,460 SF

[Click to access 3D model](#)

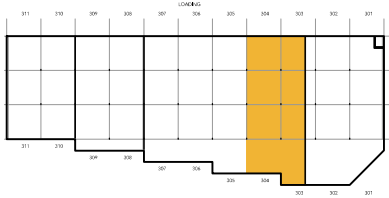

Key Plan

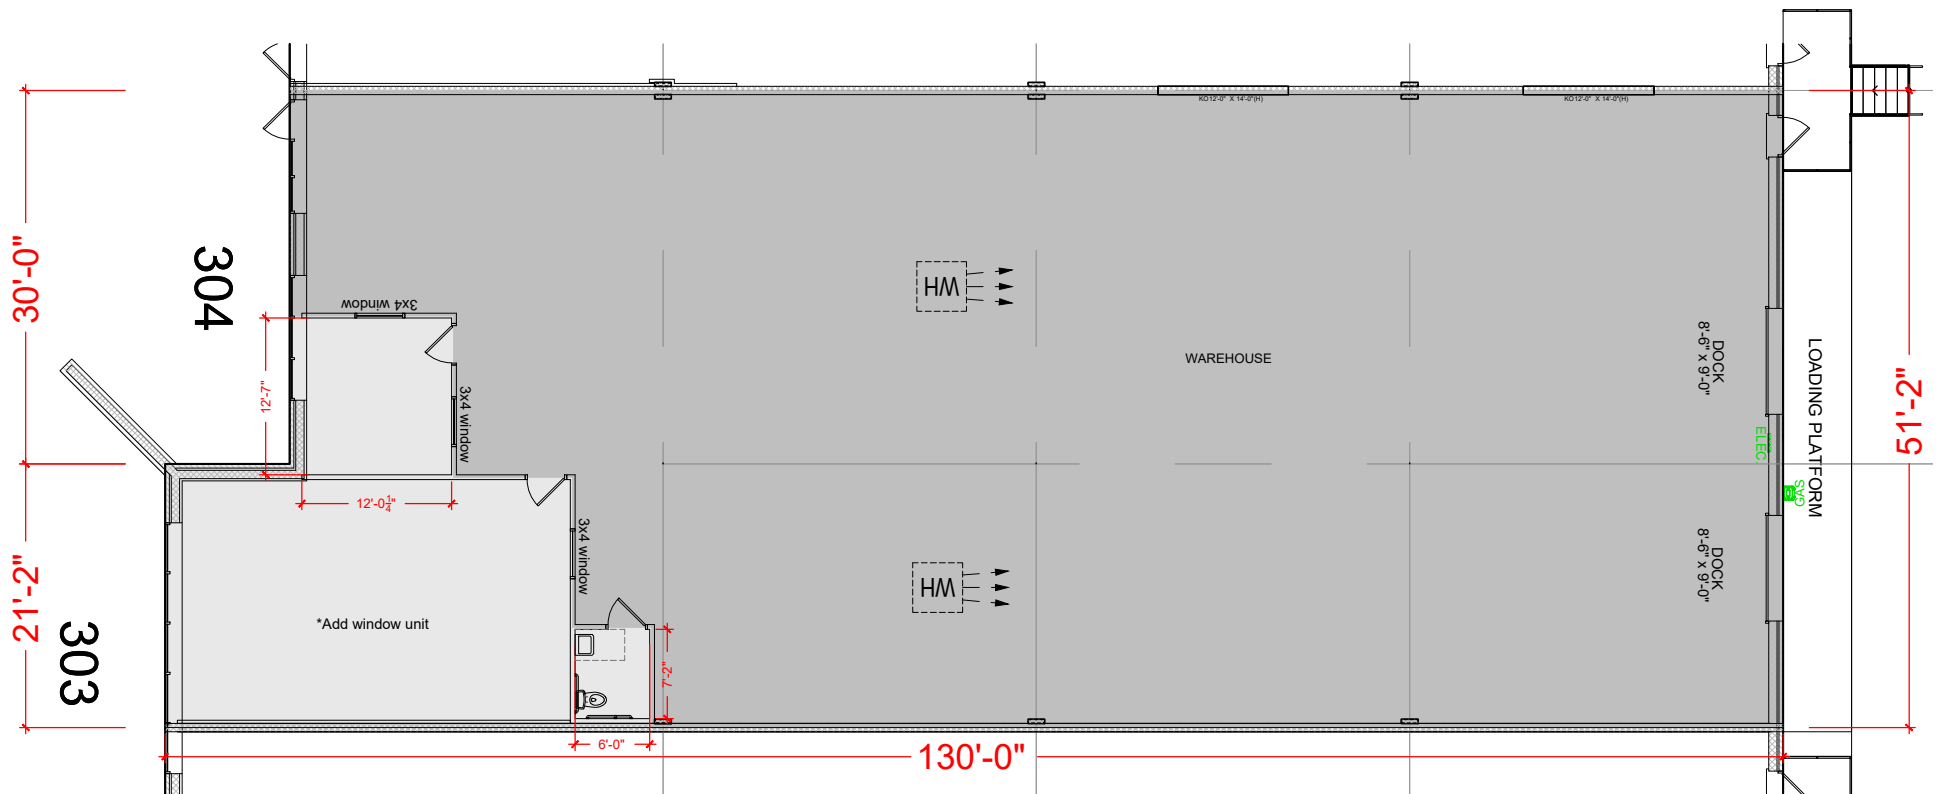

Floor Plan