


Key Plan

TOTAL SF AVAILABLE -6,600 SF

OFFICE - 1,478 SF

WAREHOUSE - 5,122 SF

[Click to access CADD file](#)

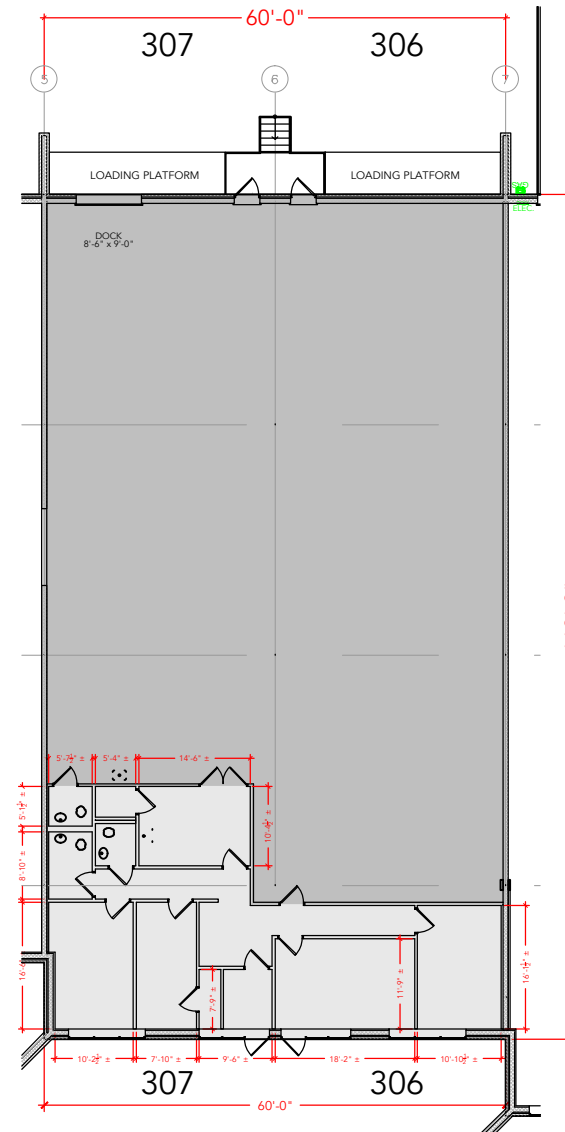

Floor Plan