


TOTAL SF AVAILABLE -6,614 RSF

OFFICE - 1,506 RSF


WAREHOUSE - 5,108 RSF

* INCLUDES % OF METER ROOM

[Click to access CADD file](#)

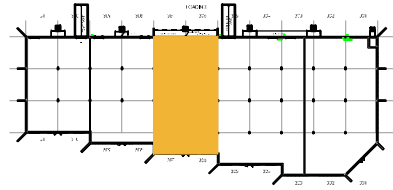

Key Plan

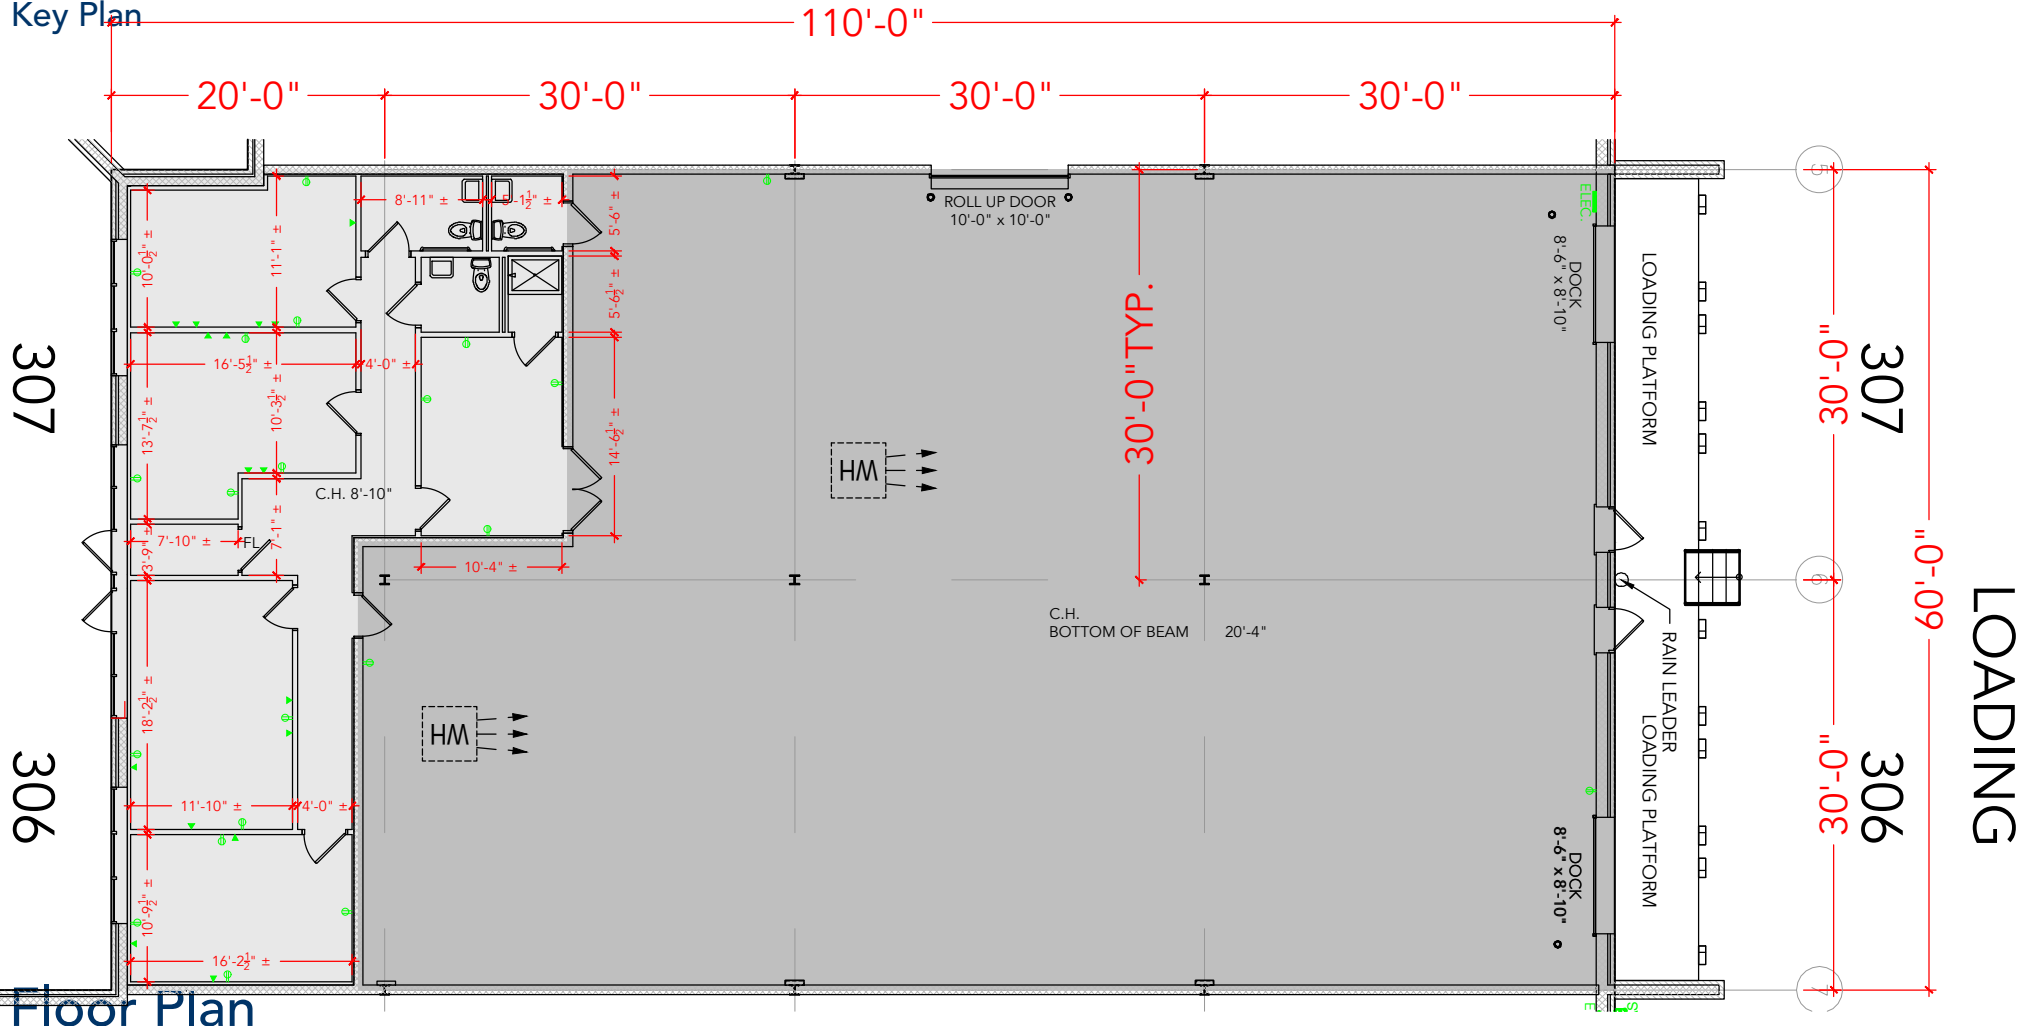

Floor Plan