


**TOTAL SF AVAILABLE -6,012 RSF**

OFFICE - 135 RSF


WAREHOUSE - 5,877 RSF

\* INCLUDES % OF METER ROOM

[Click to access CADD file](#)

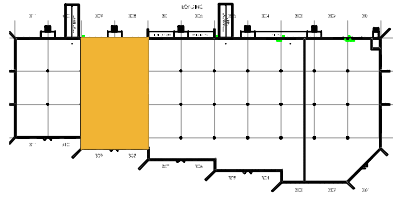

Key Plan

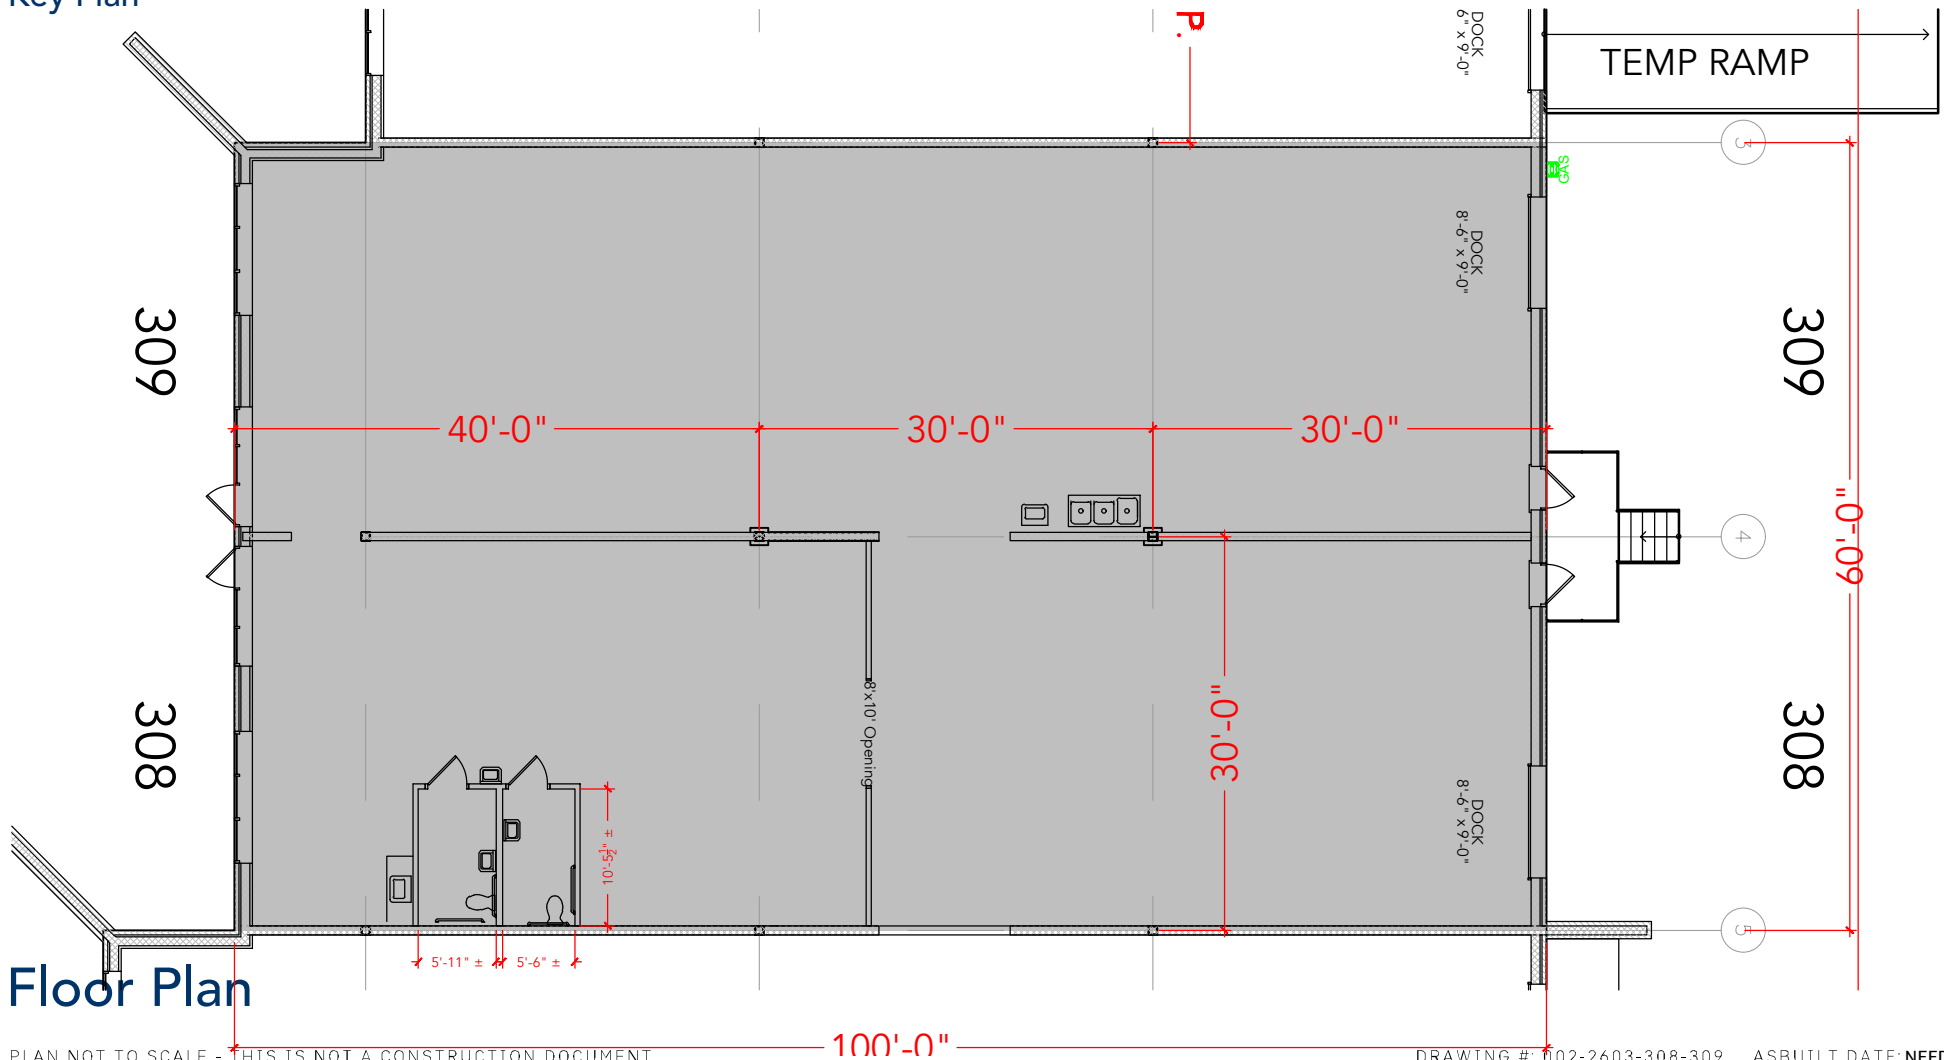

Floor Plan