


TOTAL SF AVAILABLE -6,012 RSF

OFFICE - 0,000 RSF

WAREHOUSE - 6,012 RSF

* INCLUDES % OF METER ROOM

[Click to access CADD file](#)

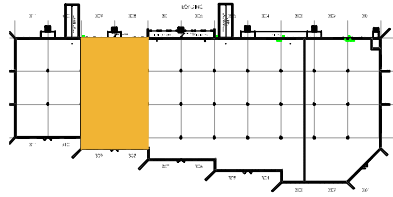

Key Plan

