


Key Plan

TOTAL SF AVAILABLE -11,143 SF

OFFICE - 0,000 SF

WAREHOUSE- 11,143 SF

[Click to access CADD file](#)

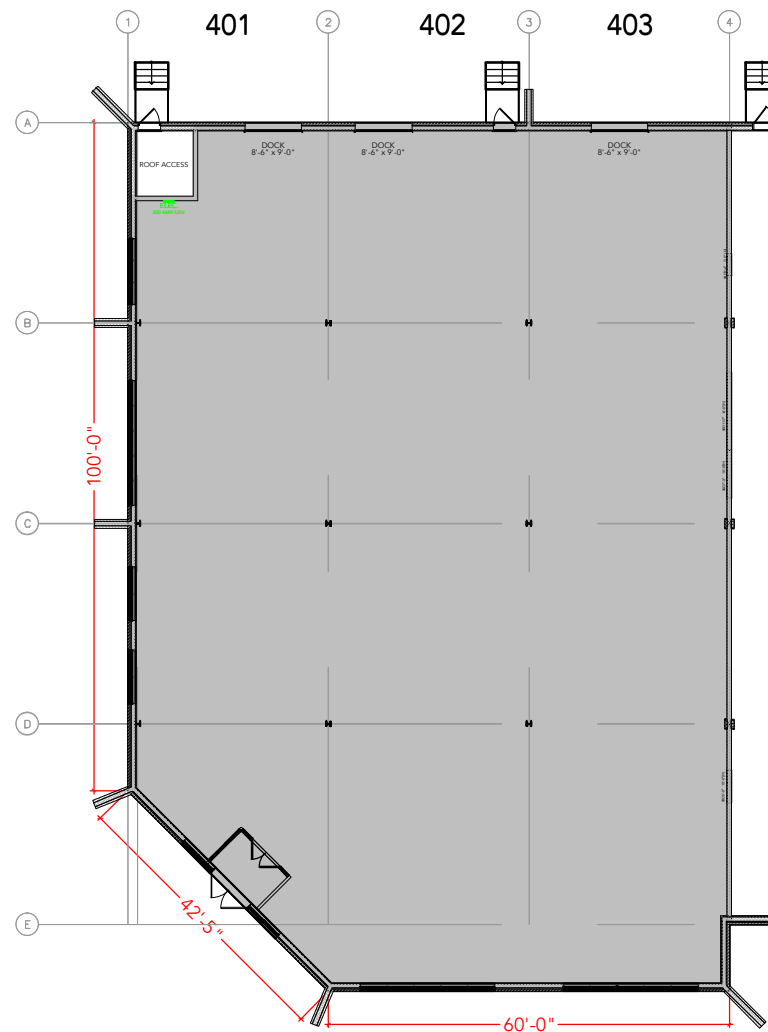

Floor Plan