


TOTAL SF AVAILABLE - 5,150 SF


OFFICE - 2,526 SF

WAREHOUSE - 2,624 SF

[Click to access 3D model](#)

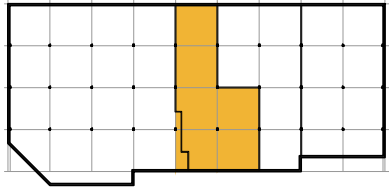

Key Plan

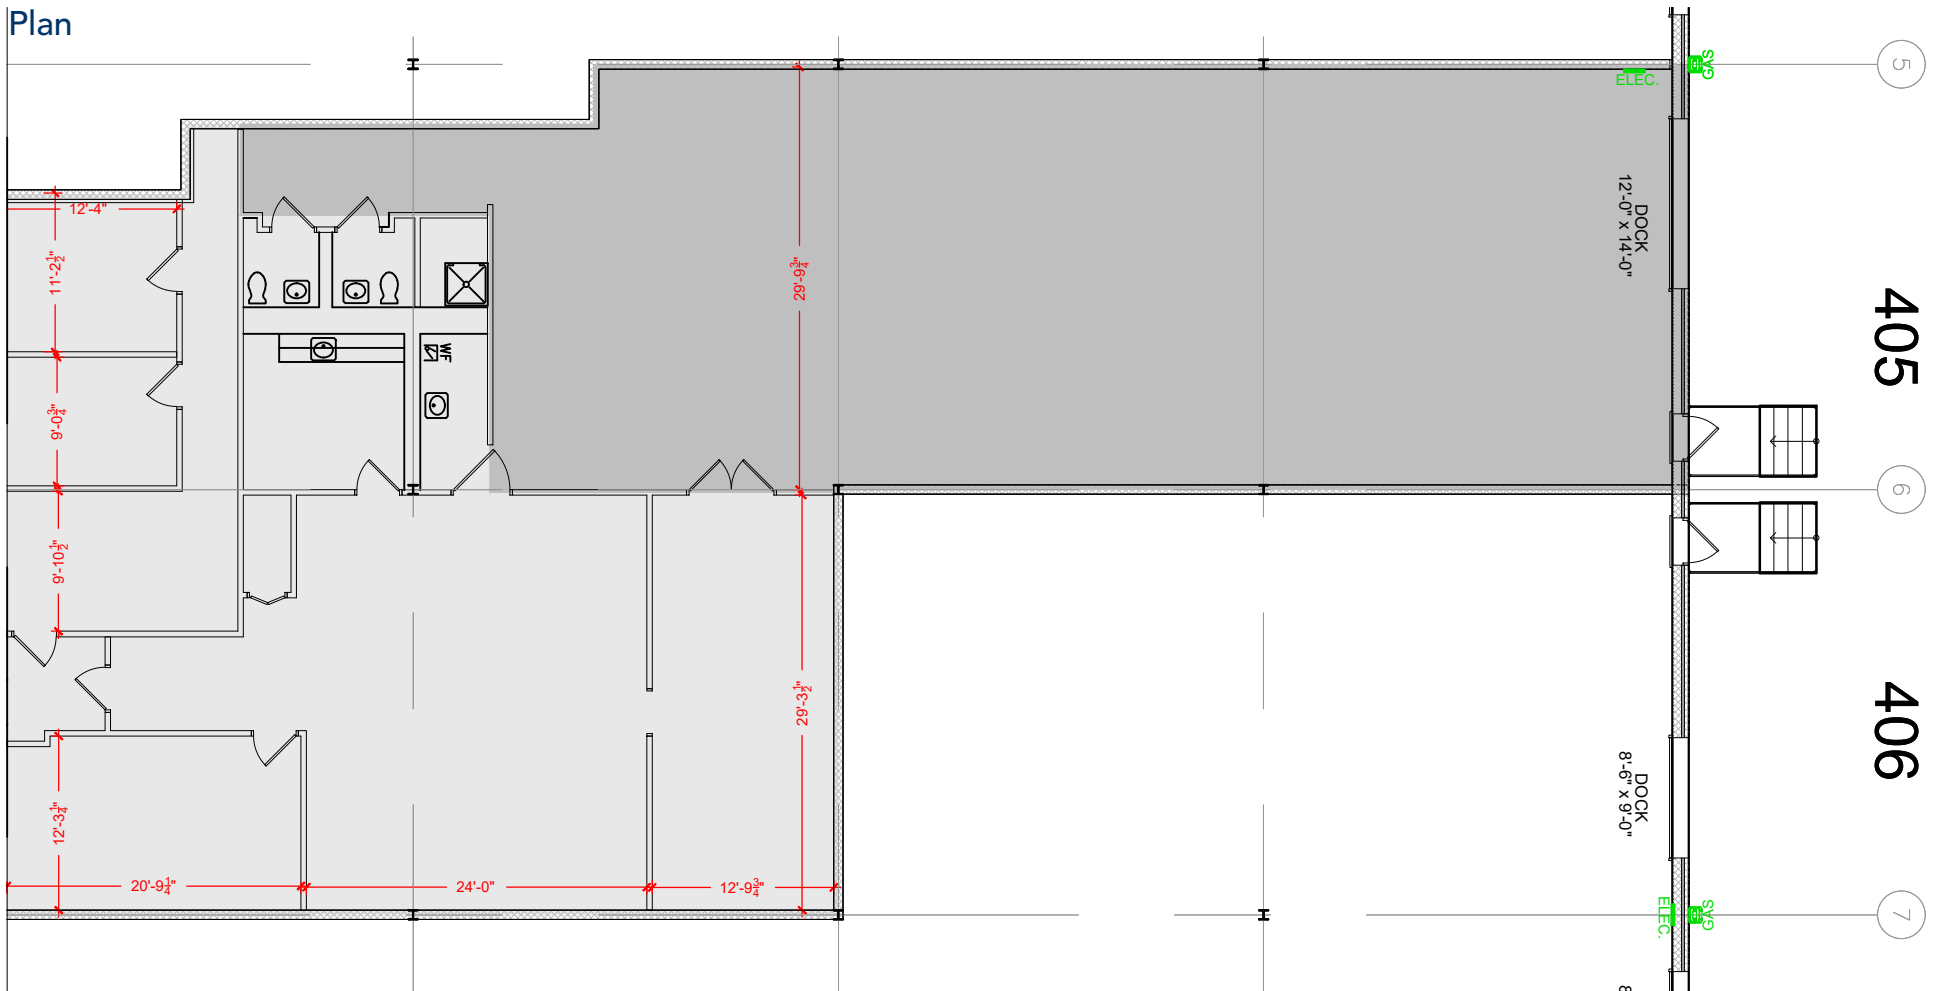

Floor Plan