


TOTAL SF AVAILABLE - 5,400 SF


OFFICE - 25,30 SF

WAREHOUSE SF - 2,870 SF

[Click to access 3D model](#)

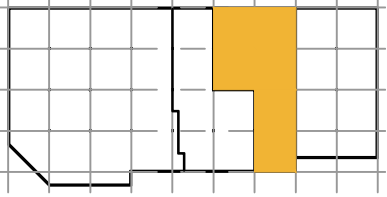

Key Plan

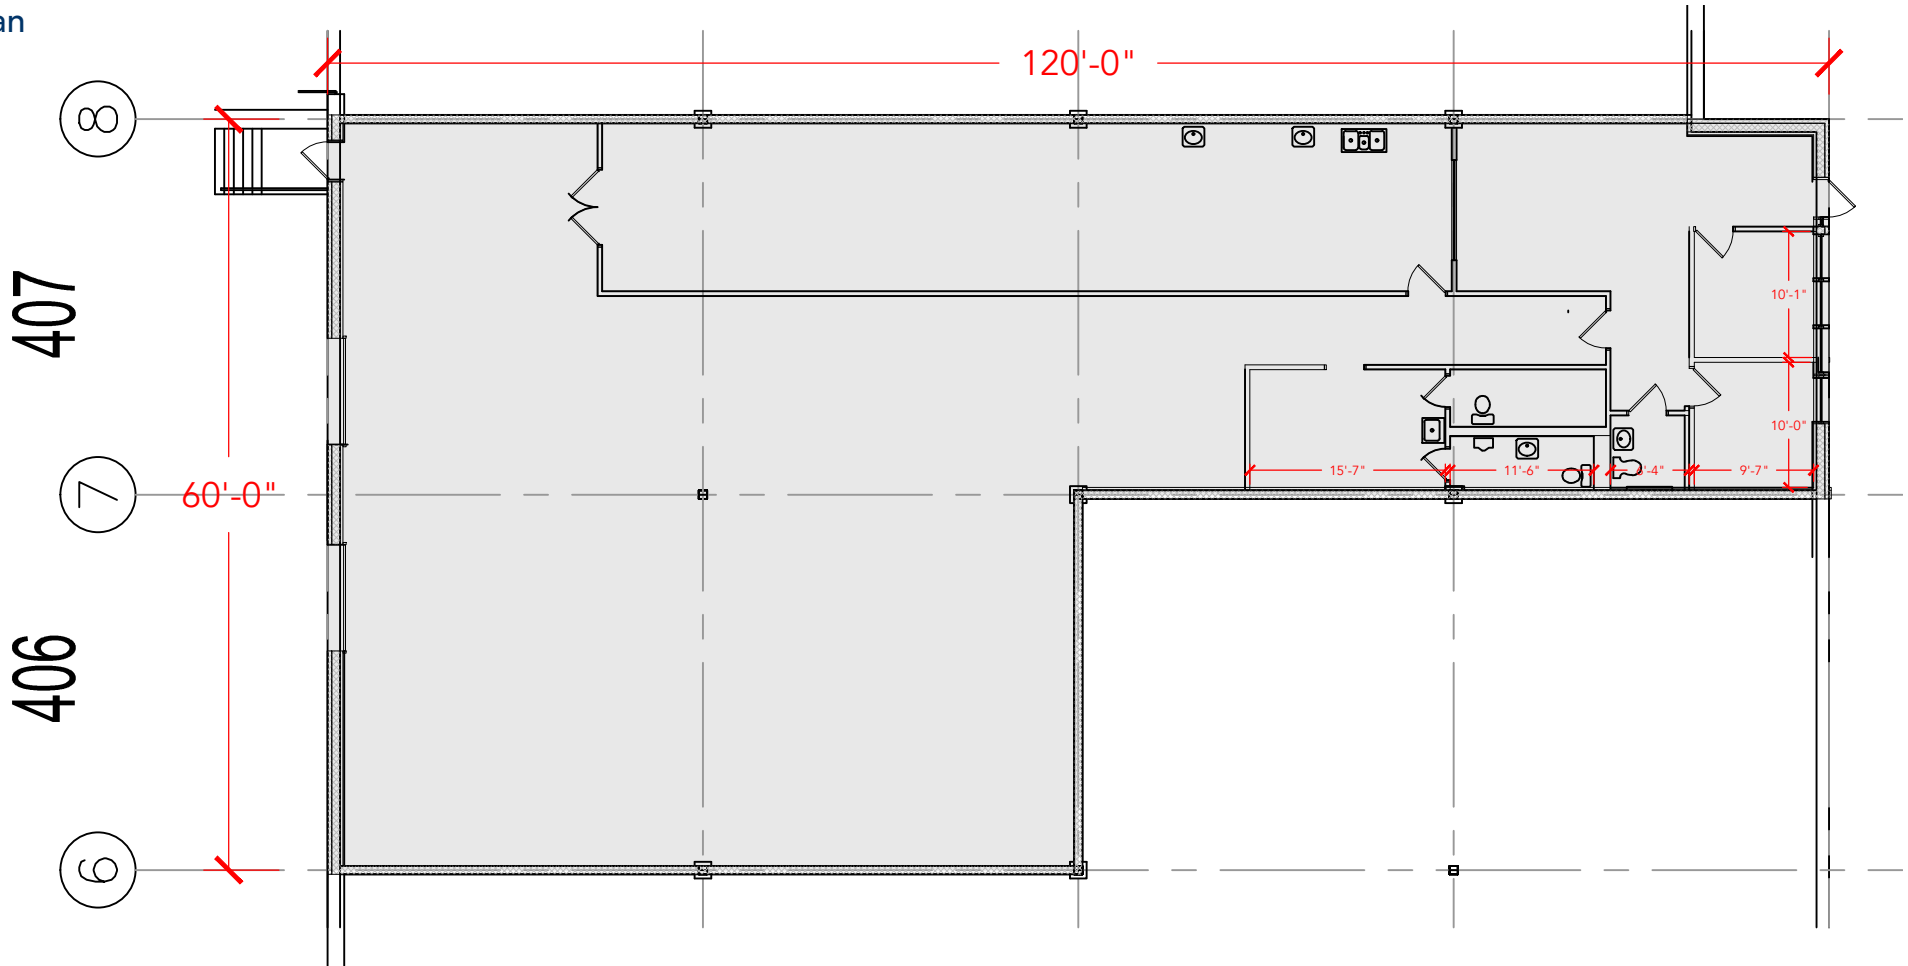

Floor Plan