


TOTAL SF AVAILABLE - 6,600 SF


OFFICE - 0,000 SF

WAREHOUSE SF - 6,600 SF

[Click to access 3D model](#)

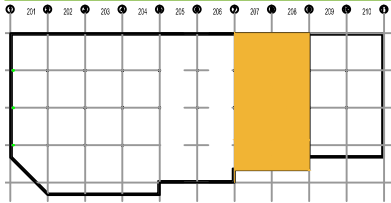

Key Plan

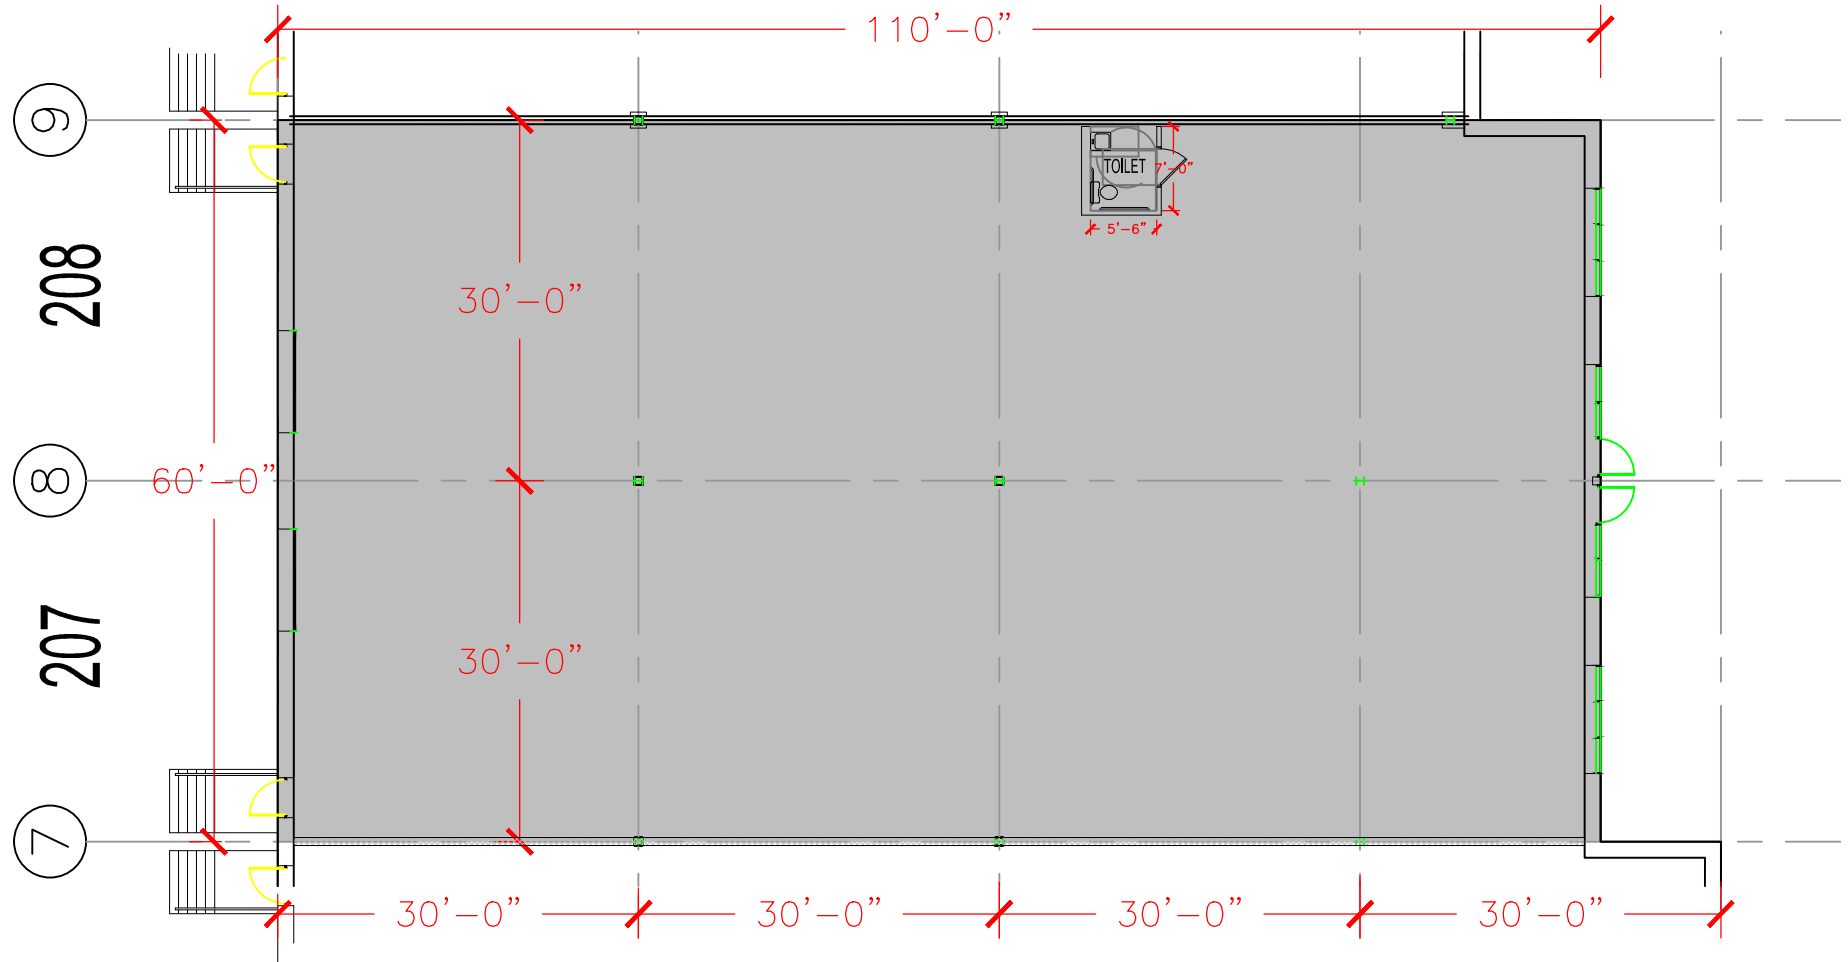

Floor Plan