



TOTAL SF AVAILABLE -23,487 SF

OFFICE - 1,380 SF
WAREHOUSE SF - 22,107 SF

[Click to access 3D model](#)

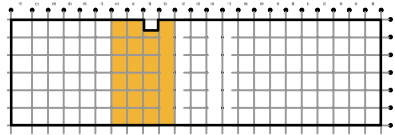

Key Plan

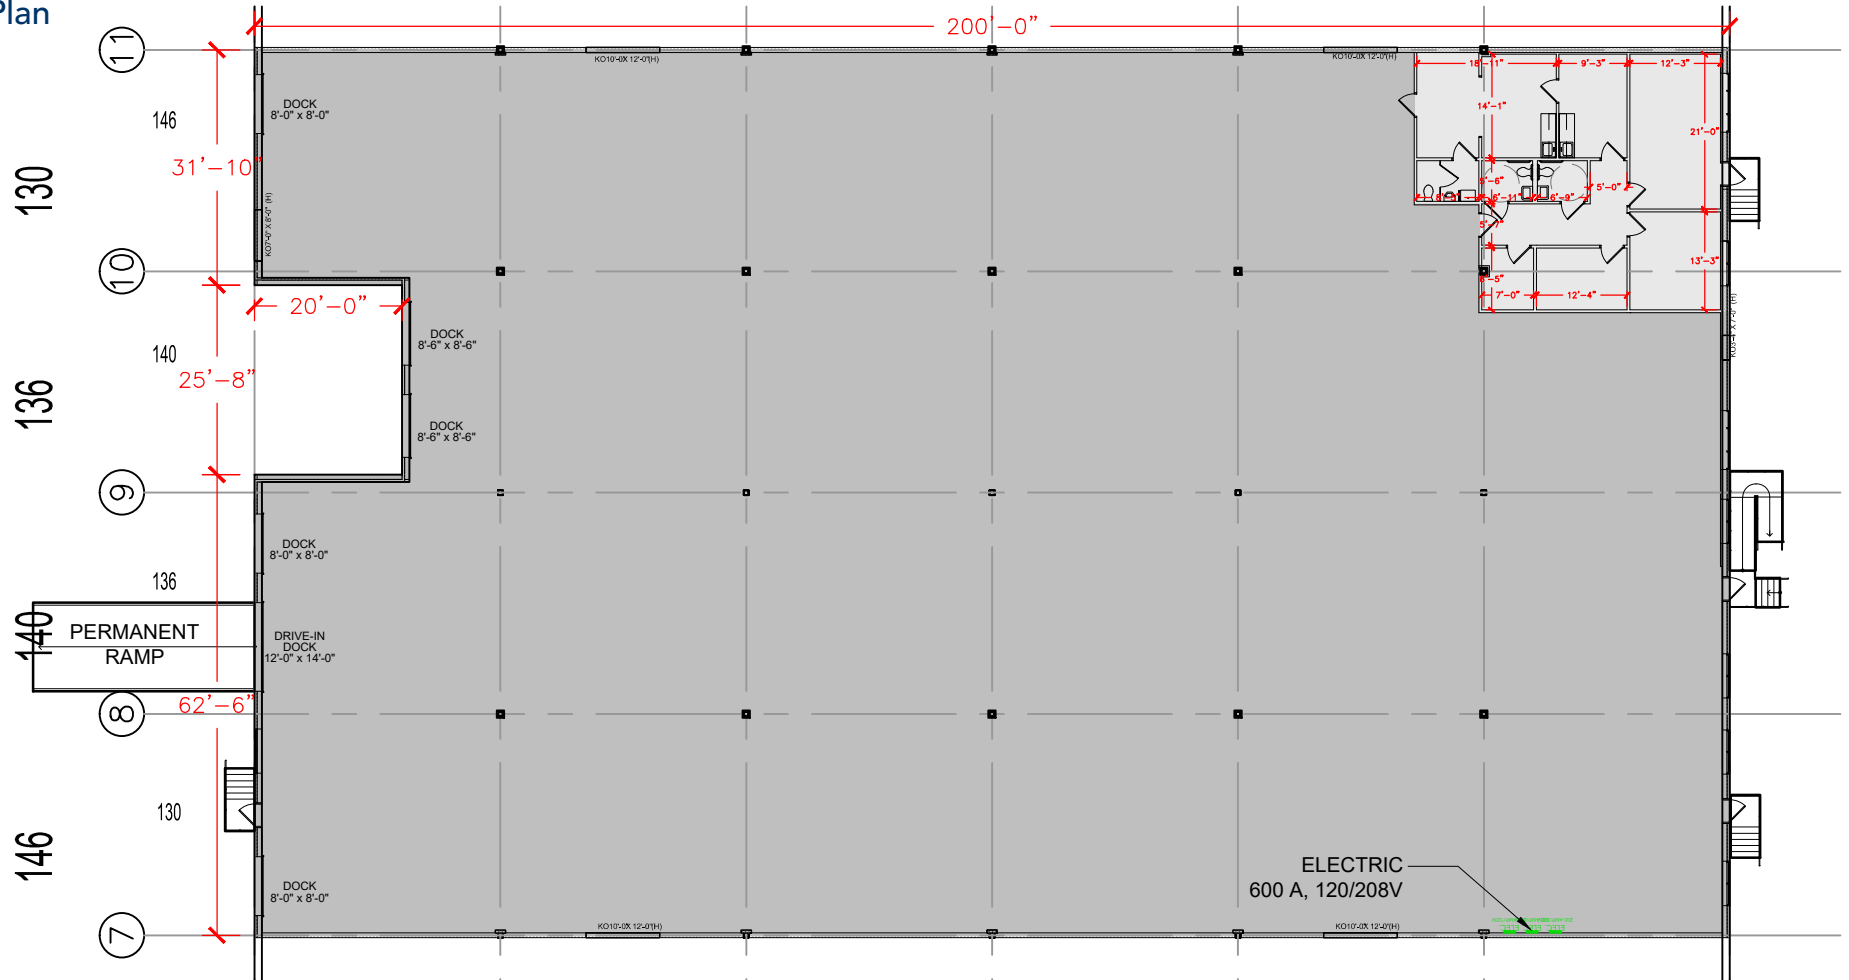

Floor Plan