


TOTAL SF AVAILABLE - 38,000 SF


OFFICE - 1,048 SF

WAREHOUSE SF - 36,952 SF

[Click to access 3D model](#)

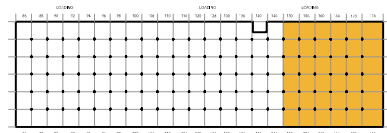

Key Plan

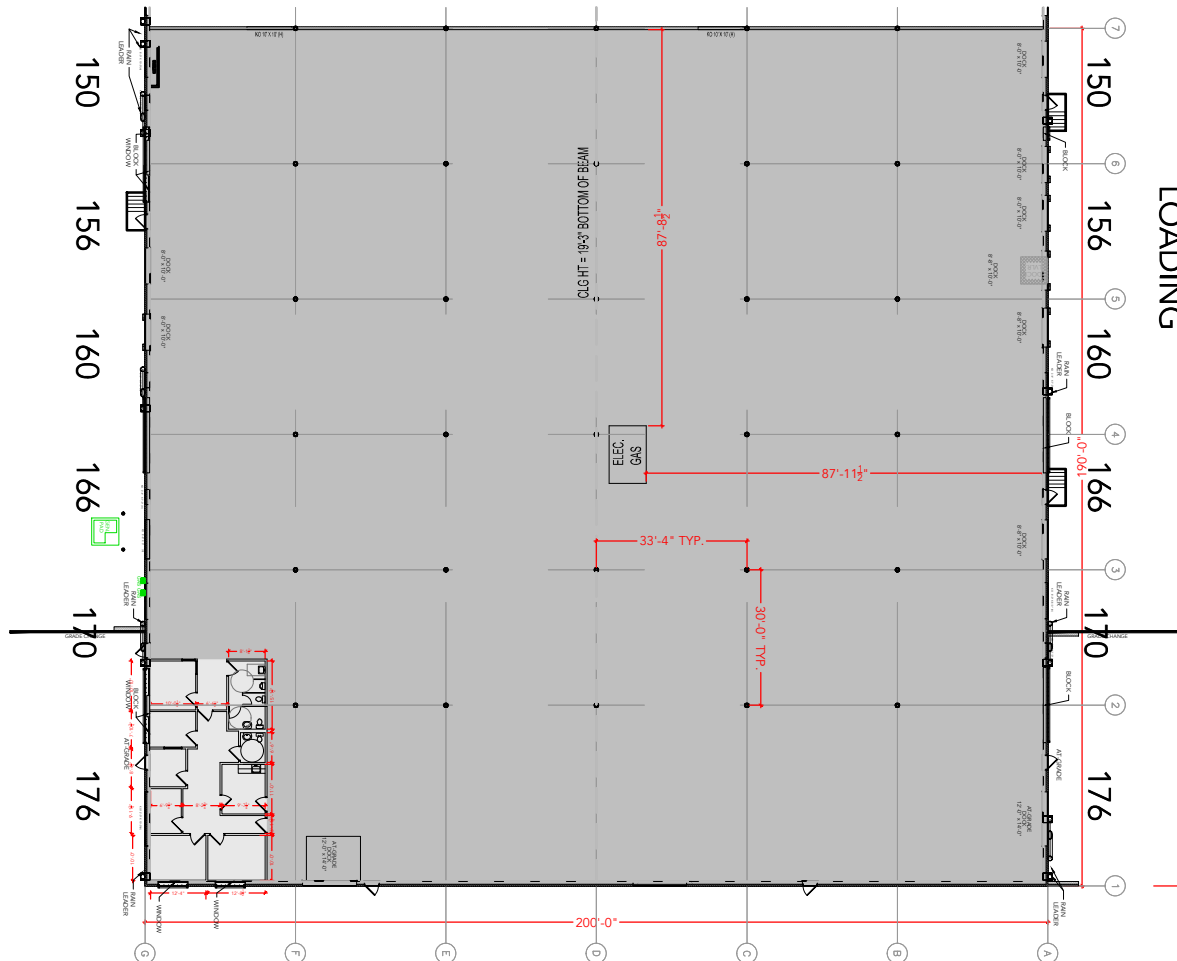

Floor Plan