


**TOTAL SF AVAILABLE -38,107 RSF**

**OFFICE - 1,364 RSF**


**WAREHOUSE - 36,743 RSF**

\* INCLUDES % OF METER ROOM

[Click to access CADD file](#)

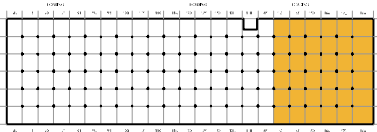

## Key Plan

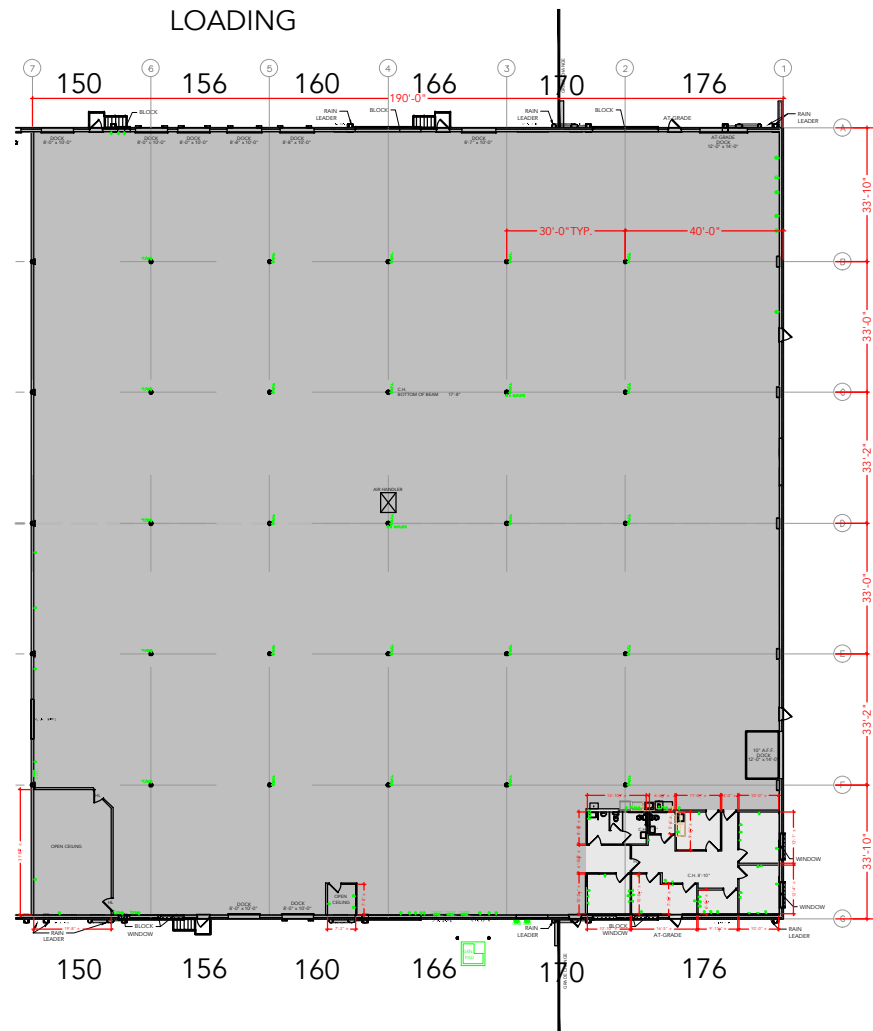

## Floor Plan