

HOLLINS FERRY TWO



4708-4710-HOLLINS FERRY ROAD
BALTIMORE, MD 21227

Building Key Plan

TOTAL SF AVAILABLE - 8,400 SF

OFFICE - 7,091 SF

WAREHOUSE SF - 1,309 SF

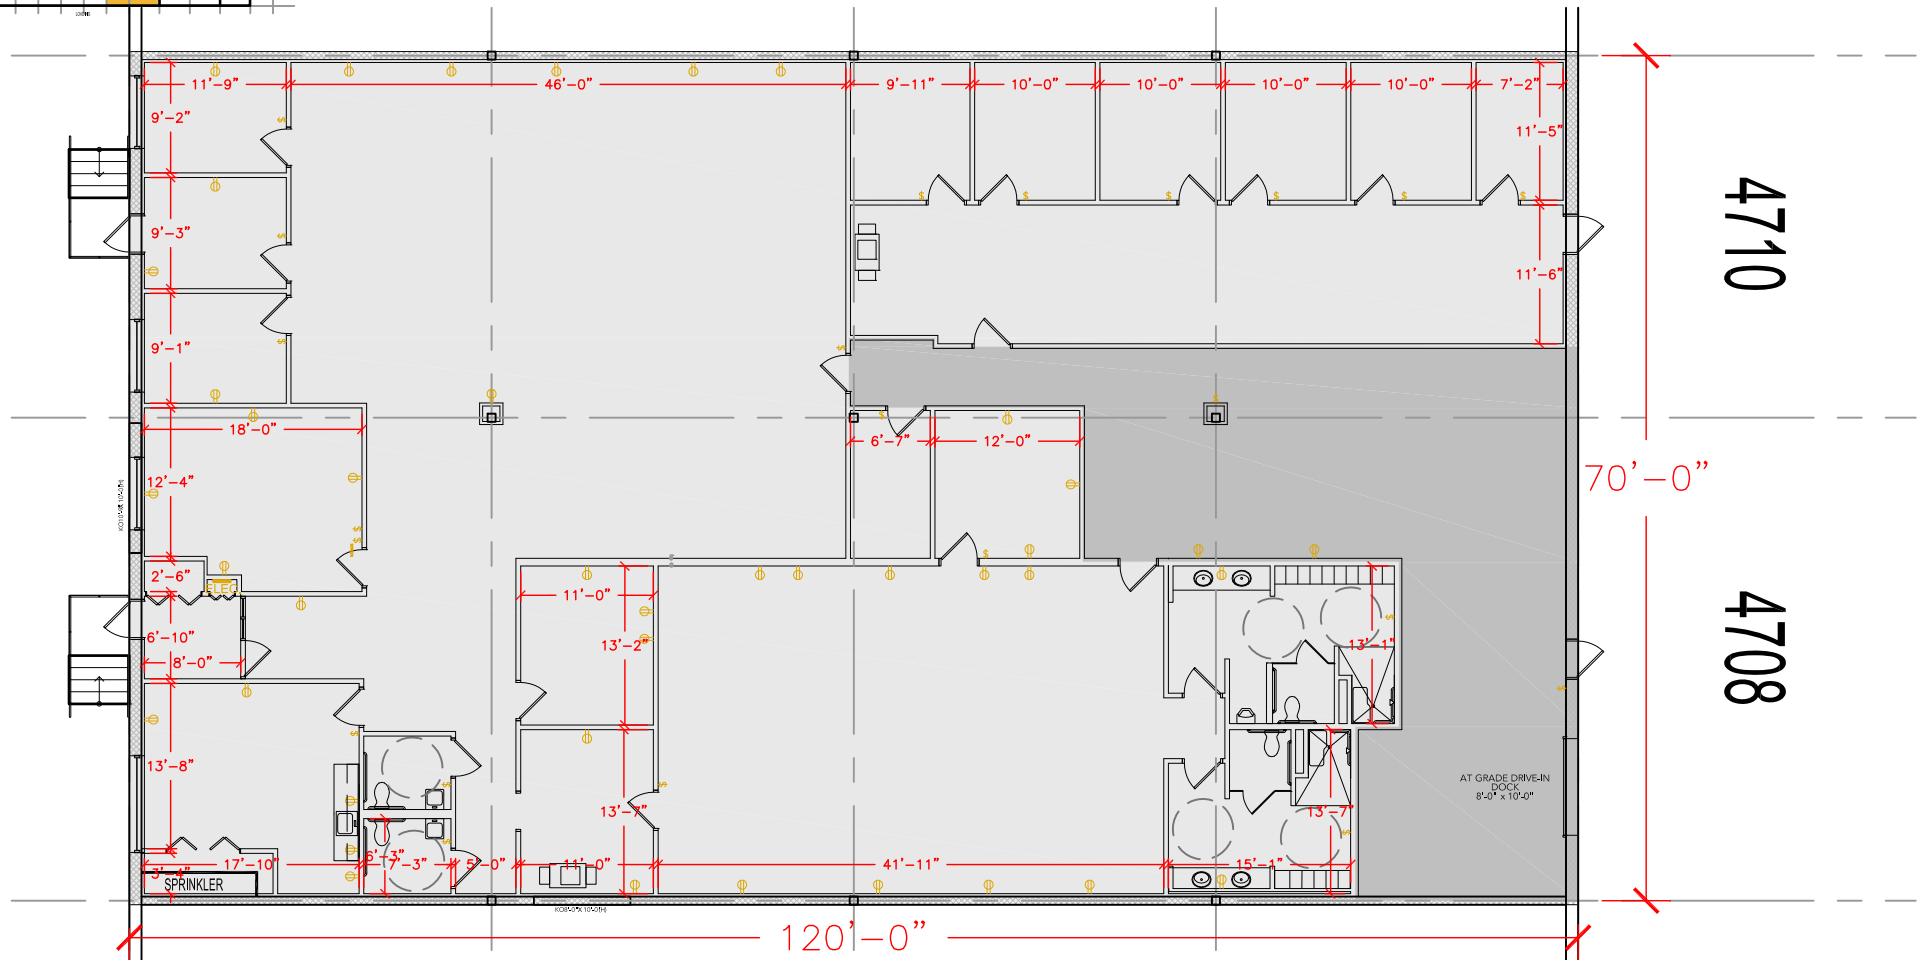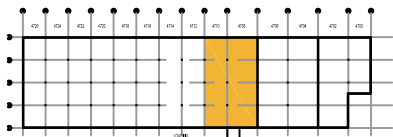

PLAN NOT TO SCALE - THIS IS NOT A CONSTRUCTION DOCUMENT

DRAWING #: 014-4708-4710 ASBUILT DATE:

01.09.2018

A Development of Merritt Properties

410.298.2600 / MerrittProperties.com