


HOLLINS FERRY TWO

4712-4716 HOLLINS FERRY ROAD
BALTIMORE, MD 21227


Building Key Plan

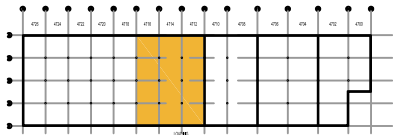

TOTAL SF AVAILABLE - 10,800 SF

OFFICE - 10,800 SF

WAREHOUSE SF - 0,000 SF

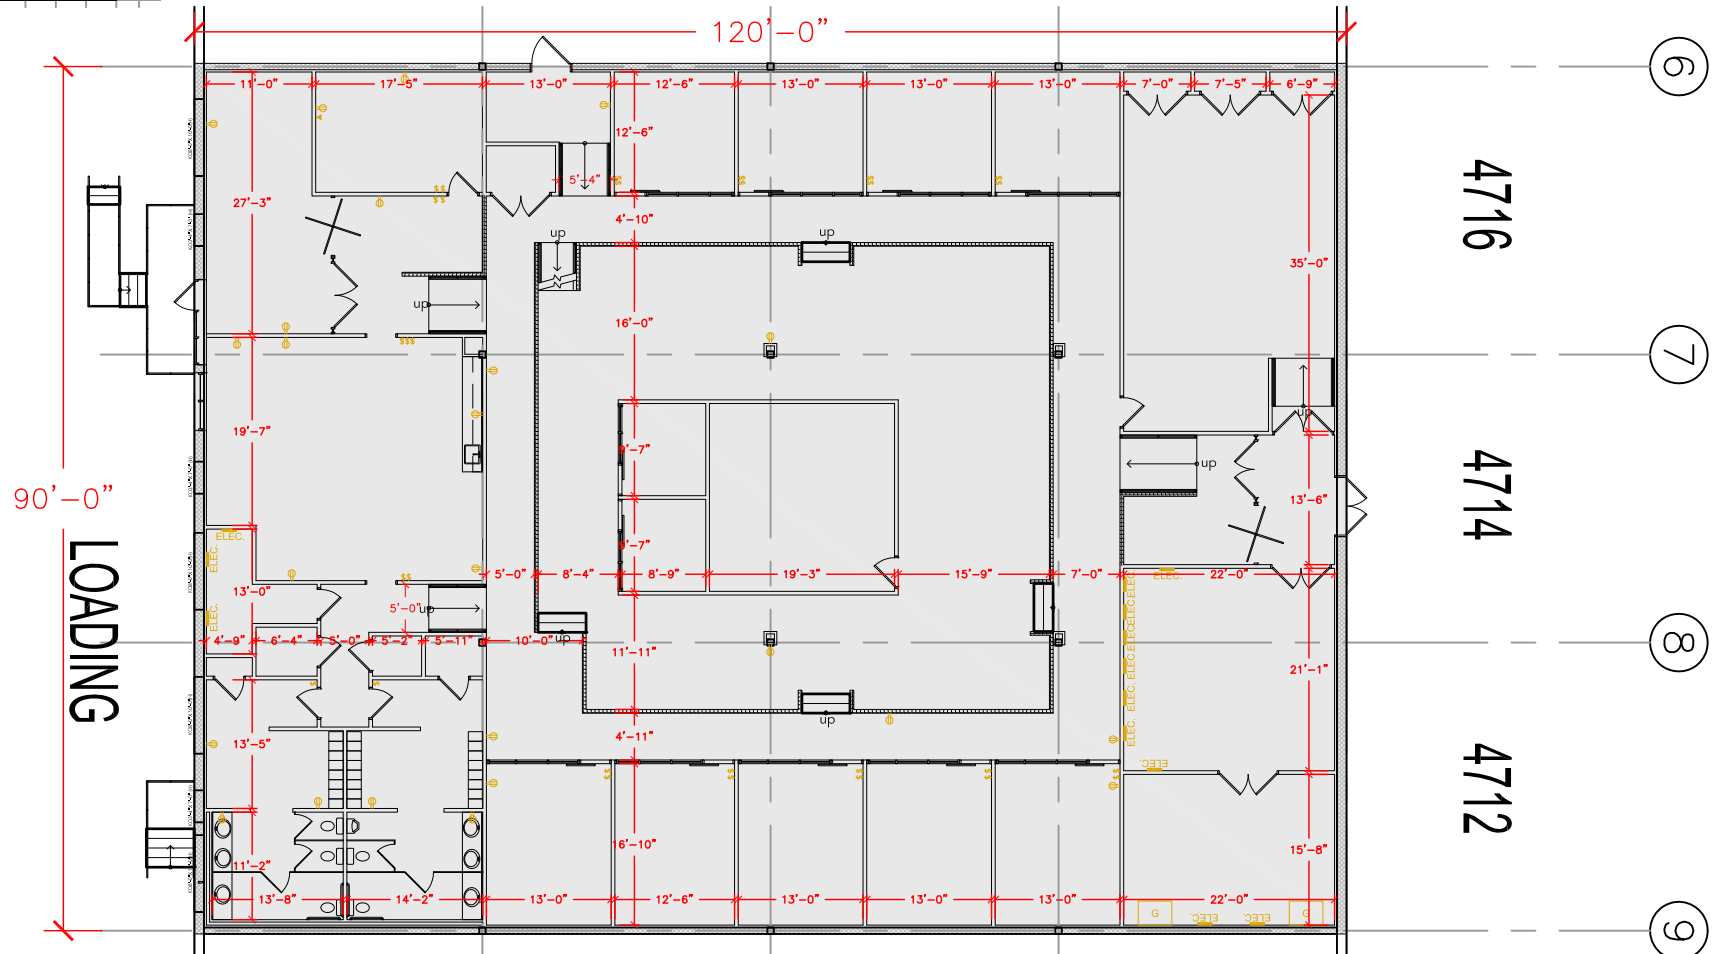

PLAN NOT TO SCALE - THIS IS NOT A CONSTRUCTION DOCUMENT

DRAWING #: 014-4712-4716 ASBUILT DATE:

01.11.2018

A Development of Merritt Properties

410.298.2600 / MerrittProperties.com