


**TOTAL SF AVAILABLE - 4,550 SF**

OFFICE - 1,572 SF



WAREHOUSE SF - 2,978 SF

\* 1,353 MEZZ. SQFT NOT INCLUDED IN TOTAL SQFT

[Click to access 3D model](#)

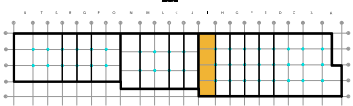

Key Plan

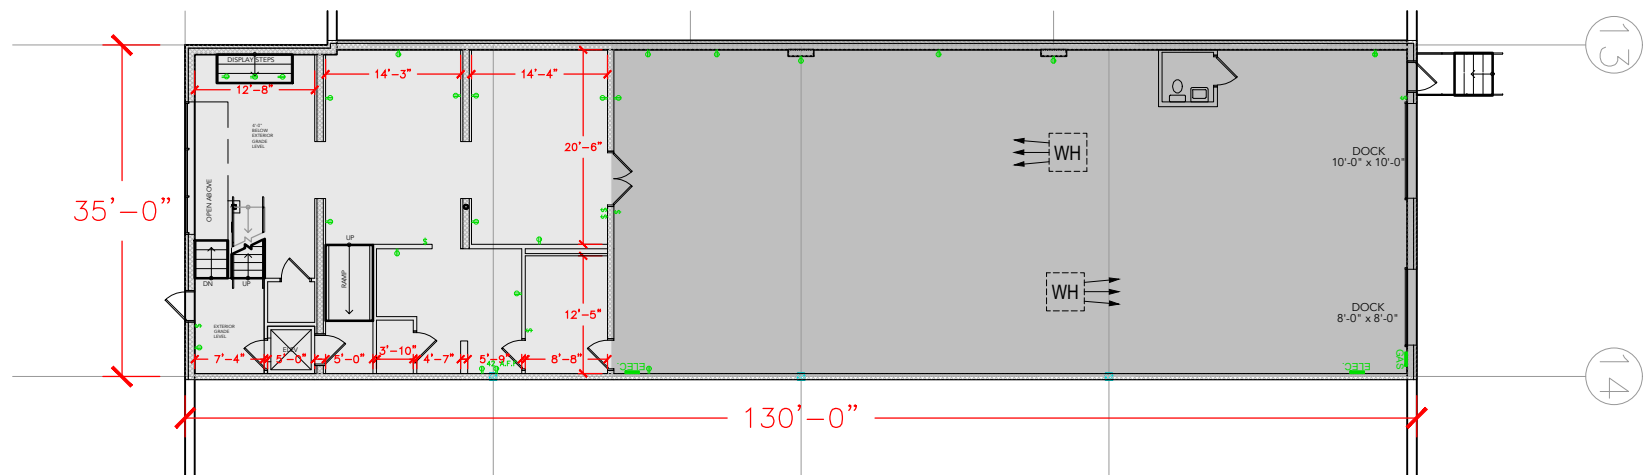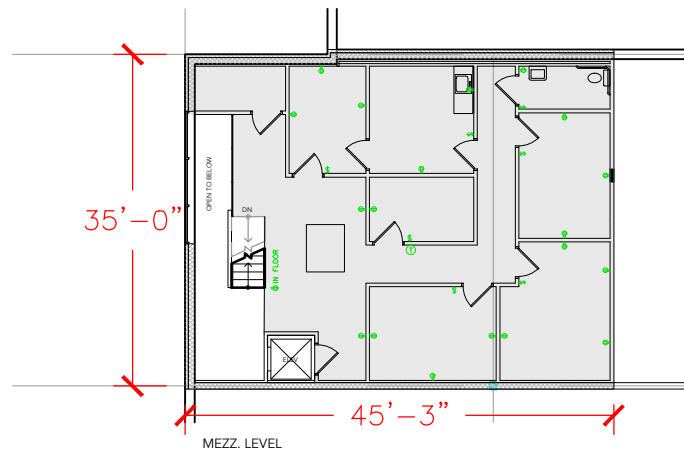

Floor Plan