


TOTAL SF AVAILABLE - 3,450 SF


OFFICE - 204 SF

WAREHOUSE - 3,246 SF

[Click to access 3D model](#)

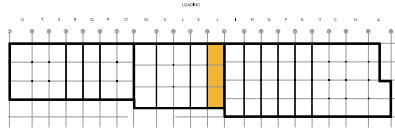

Key Plan

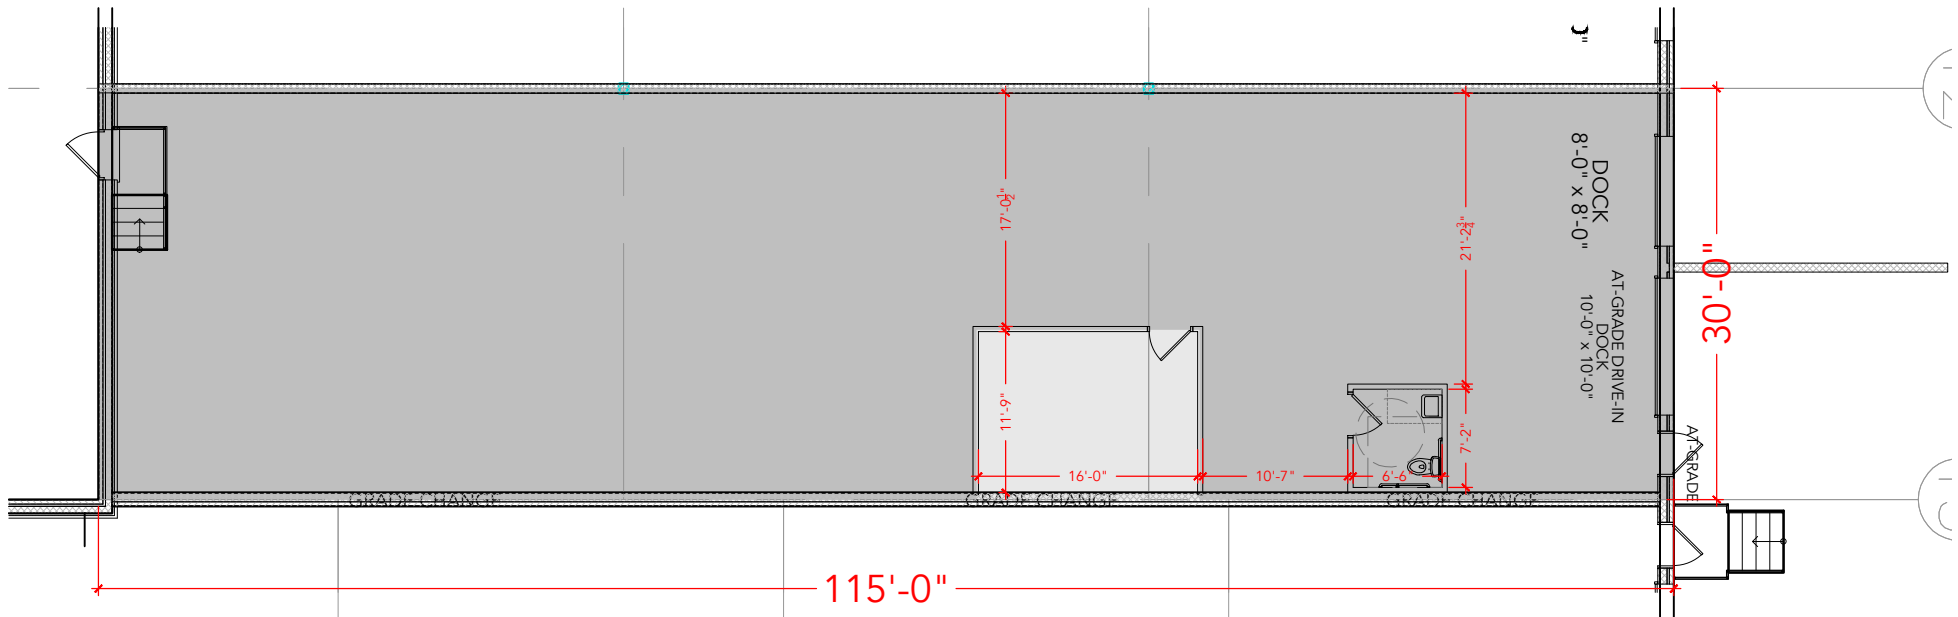

Floor Plan