


**TOTAL SF AVAILABLE - 3,450 SF**


**OFFICE - 799 SF**

**WAREHOUSE SF - 2,651 SF**

[Click to access 3D model](#)

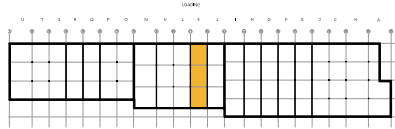

Key Plan

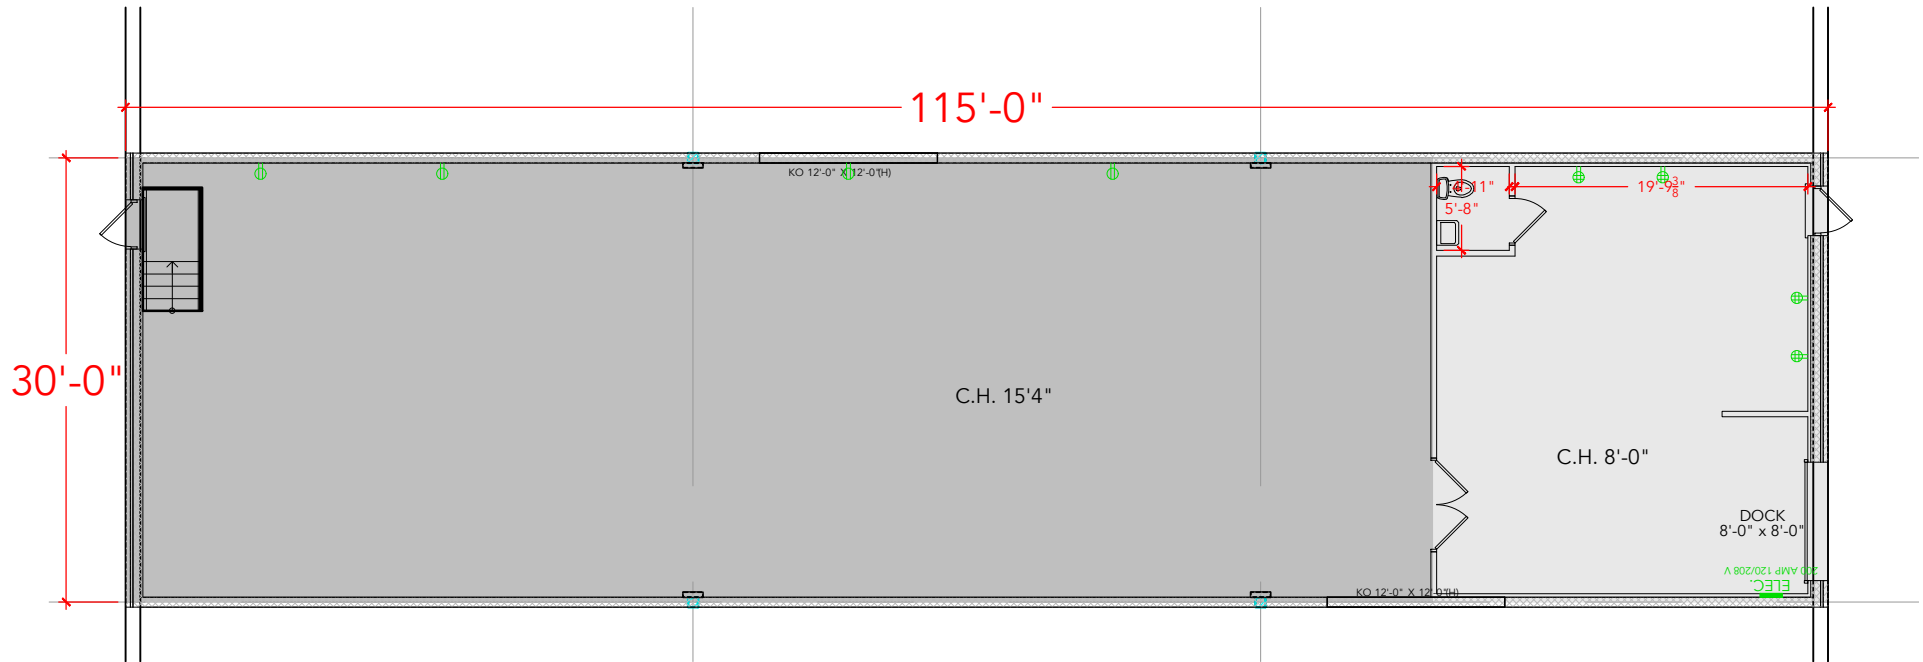

Floor Plan