


**TOTAL SF AVAILABLE - 4,510 SF**


**OFFICE - 692 SF**

**WAREHOUSE - 3,818 SF**

[Click to access 3D model](#)

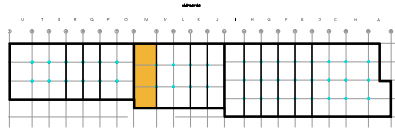

Key Plan

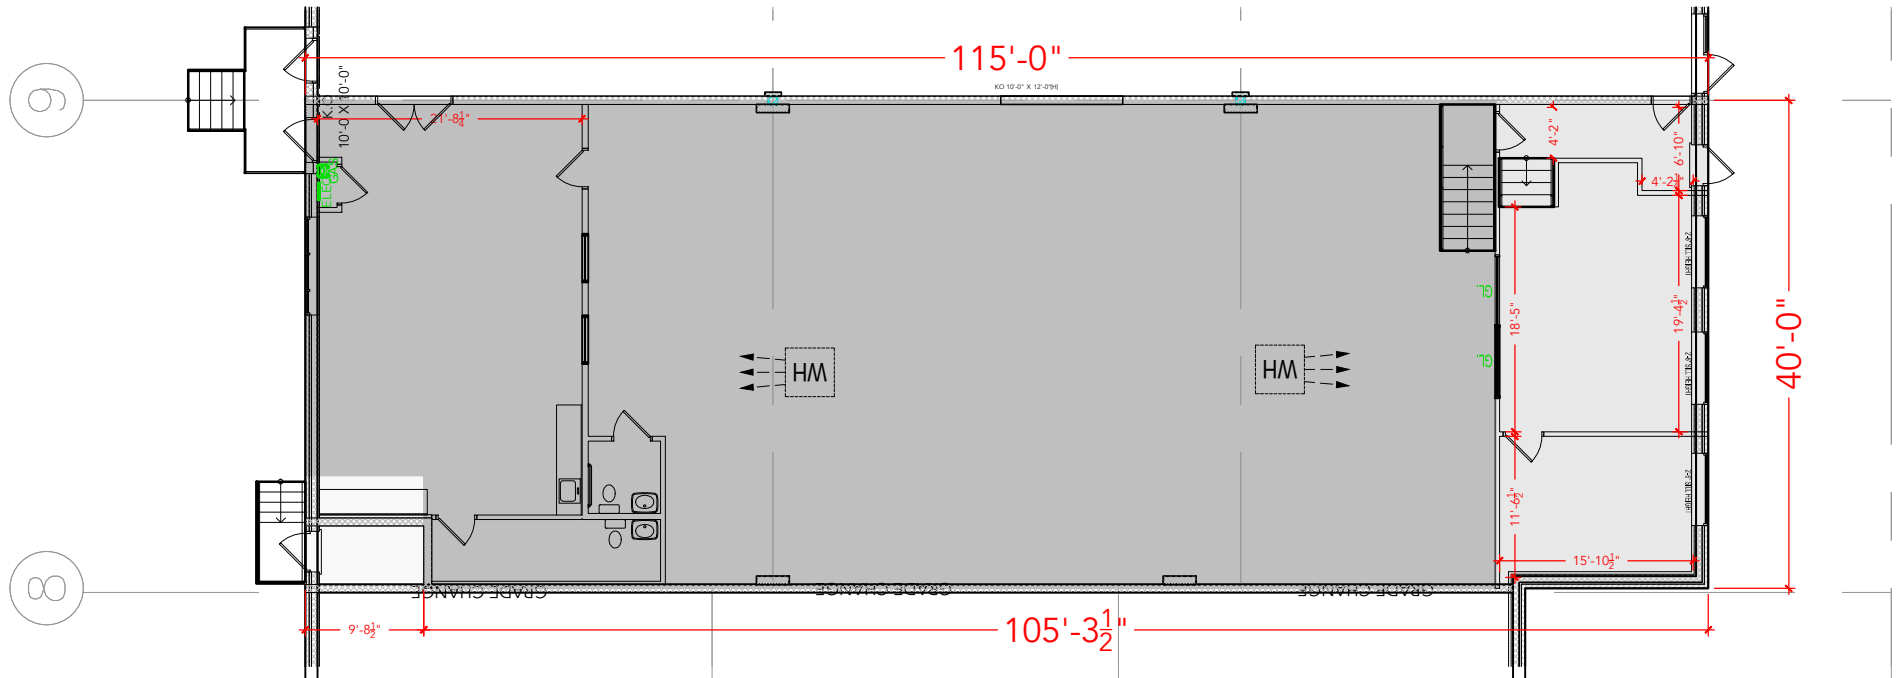

Floor Plan