


TOTAL SF AVAILABLE - 6,000 SF


OFFICE - 1,267 SF

WAREHOUSE - 4,733 SF

[Click to access 3D model](#)

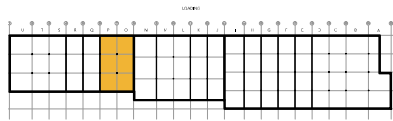

Key Plan

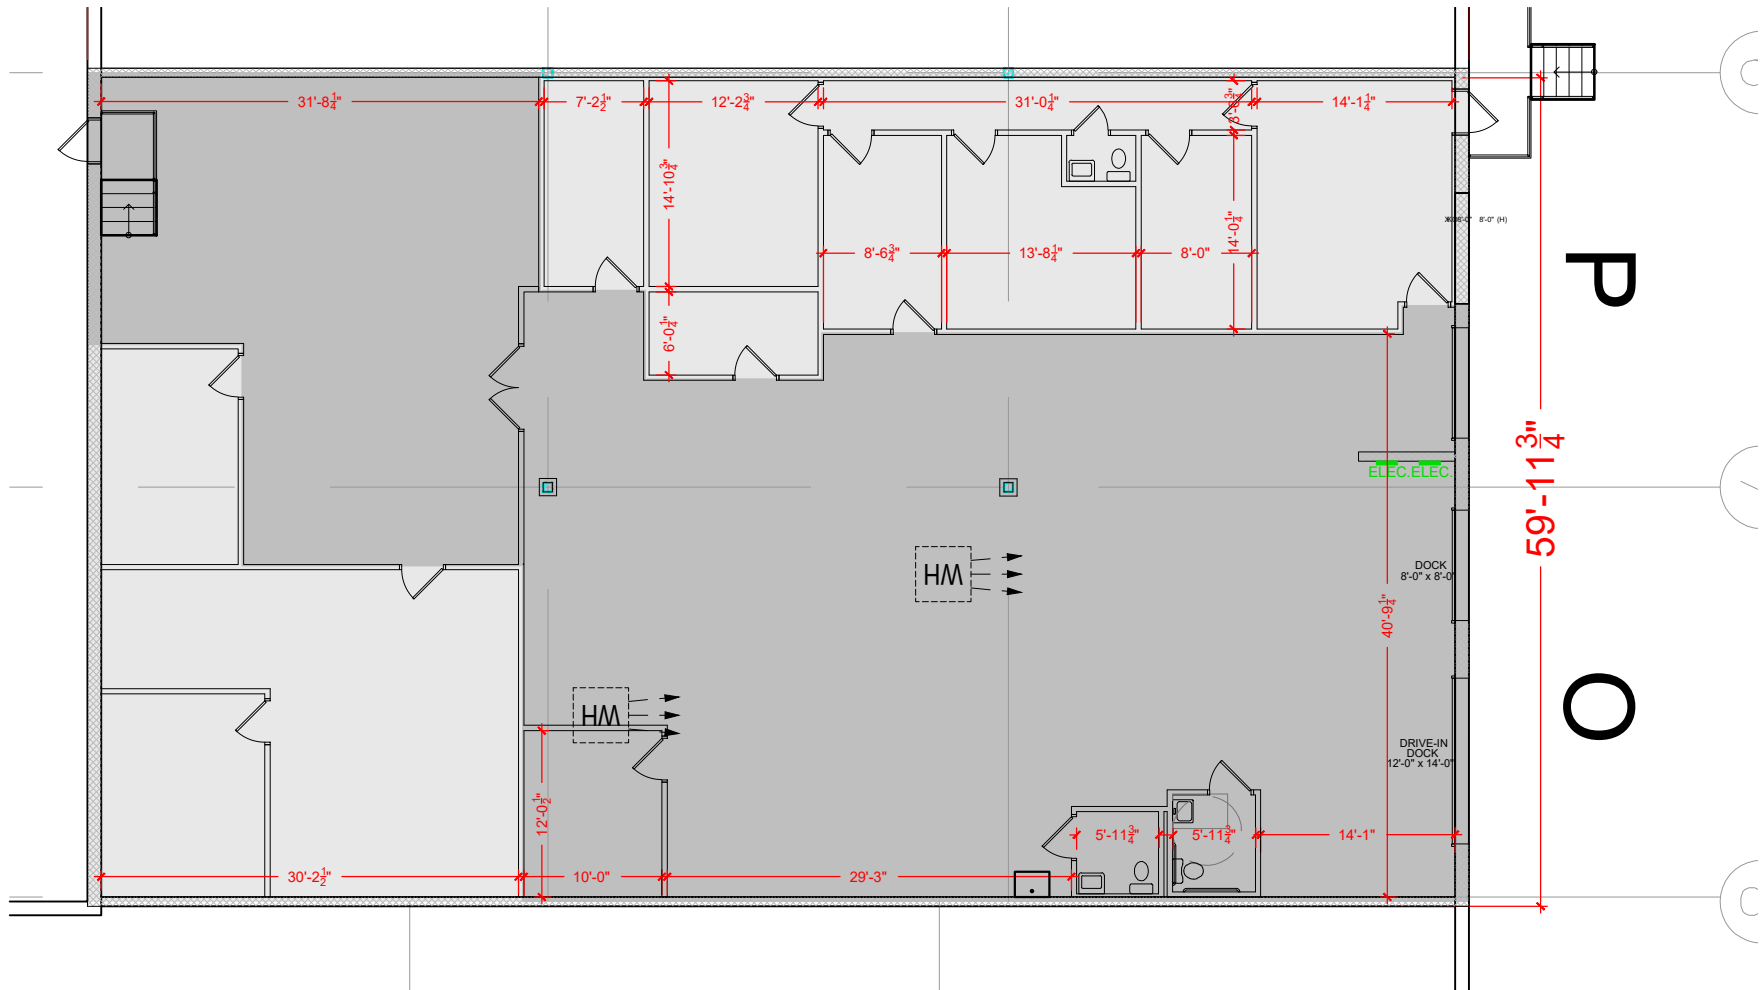

Floor Plan