


**TOTAL SF AVAILABLE - 7,910 SF**

**OFFICE - 2,567 SF**


**WAREHOUSE - 5,343 SF**

\* 407 SQFT MEZZ NOT INCLUDED IN TOTAL SQFT

[Click to access 3D model](#)

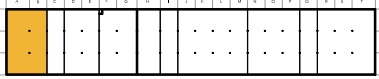

Key Plan

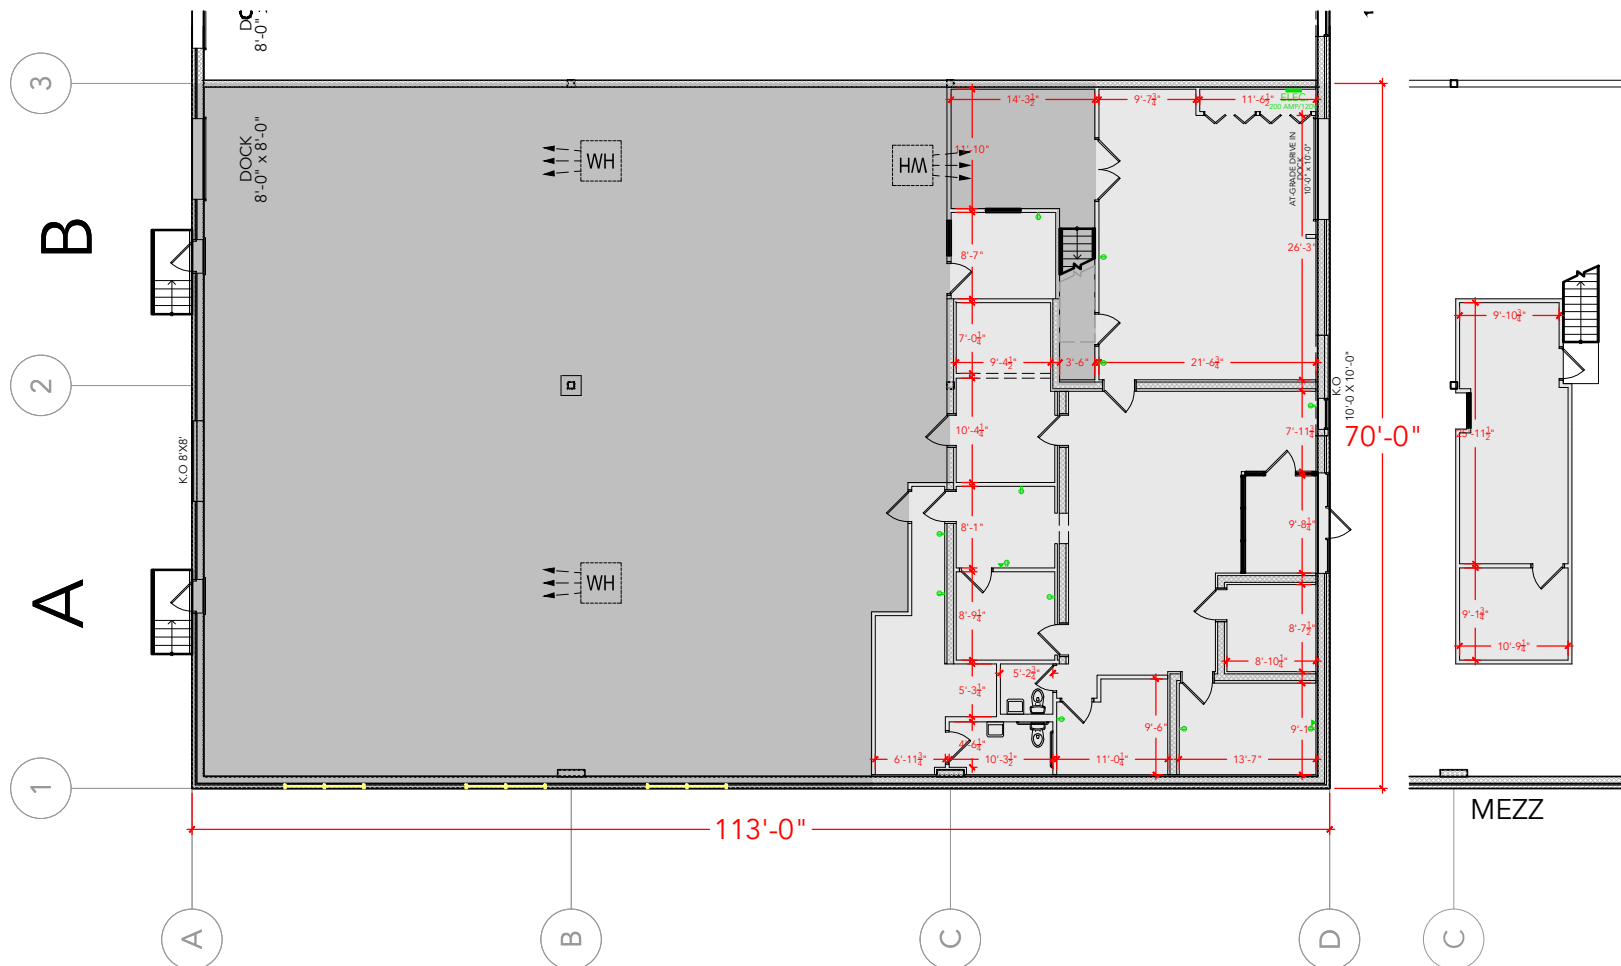

Floor Plan