


TOTAL SF AVAILABLE - 7,345 SF


OFFICE - 2,511 SF

WAREHOUSE SF - 4,834 SF

[Click to access 3D model](#)

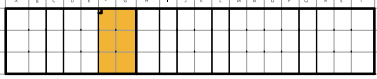

Key Plan

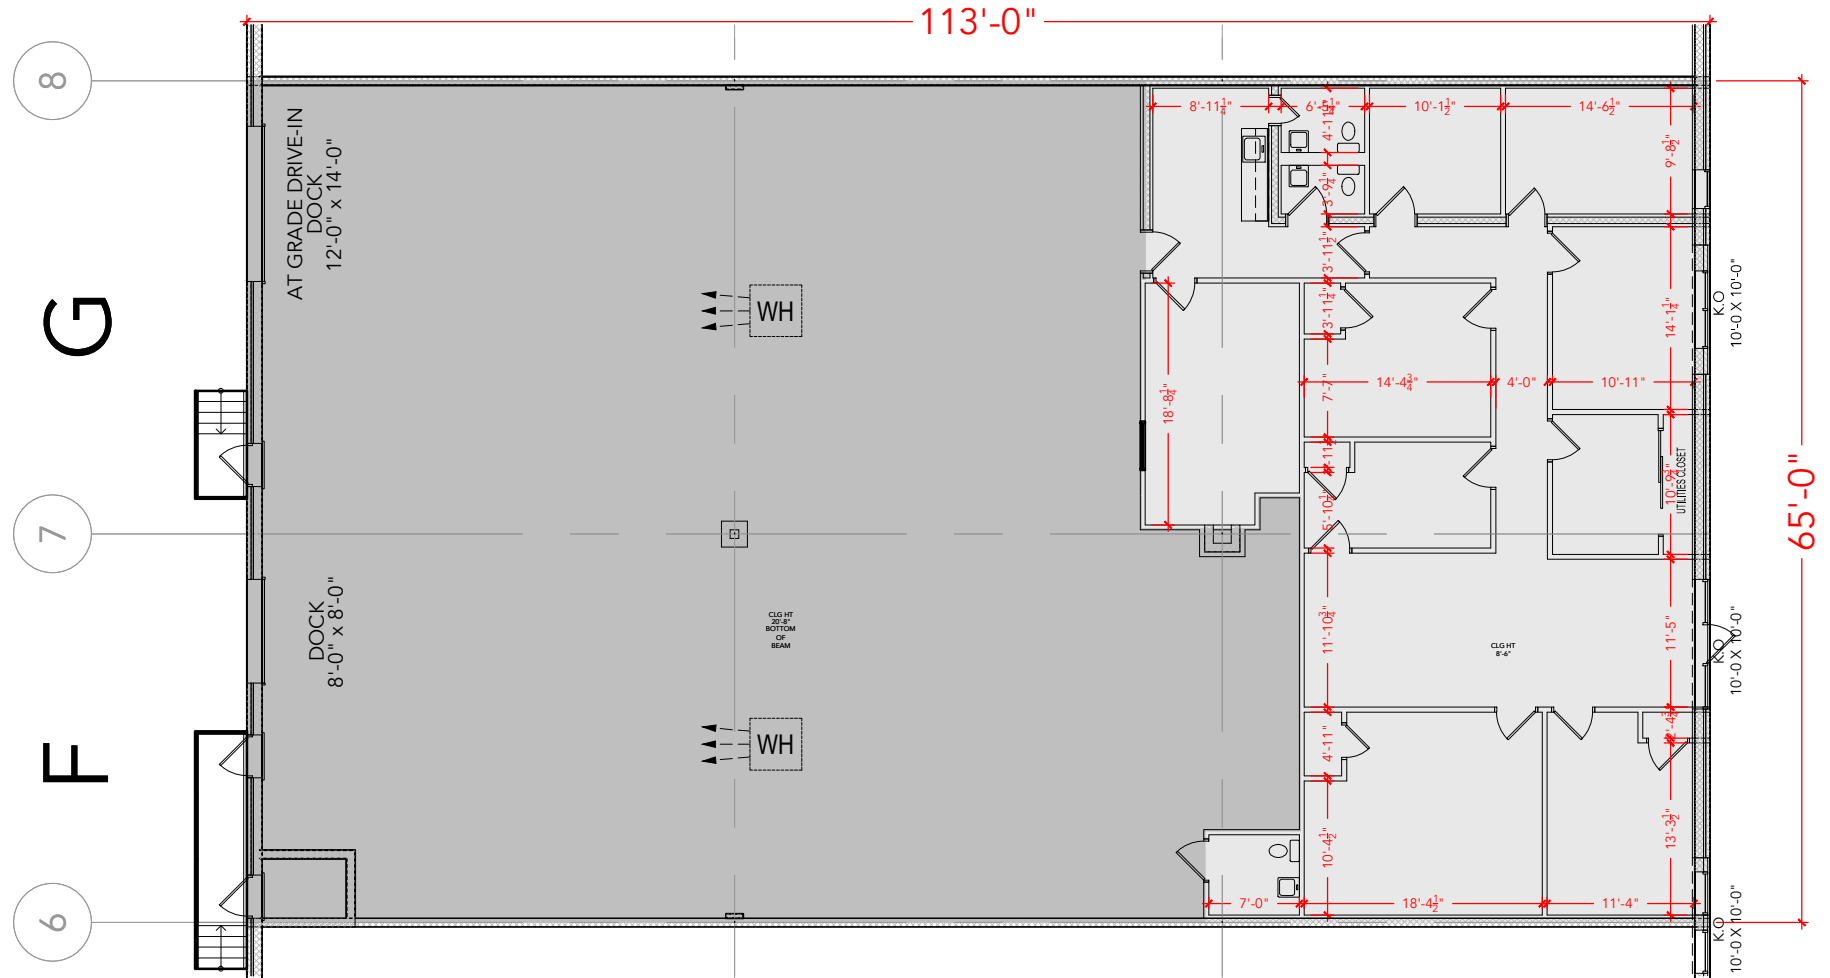

Floor Plan