


TOTAL SF AVAILABLE - 3,390 SF


OFFICE - 1,352 SF

WAREHOUSE SF - 3,390 SF

[Click to access 3D model](#)

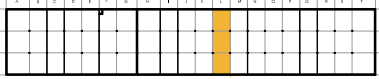

Key Plan

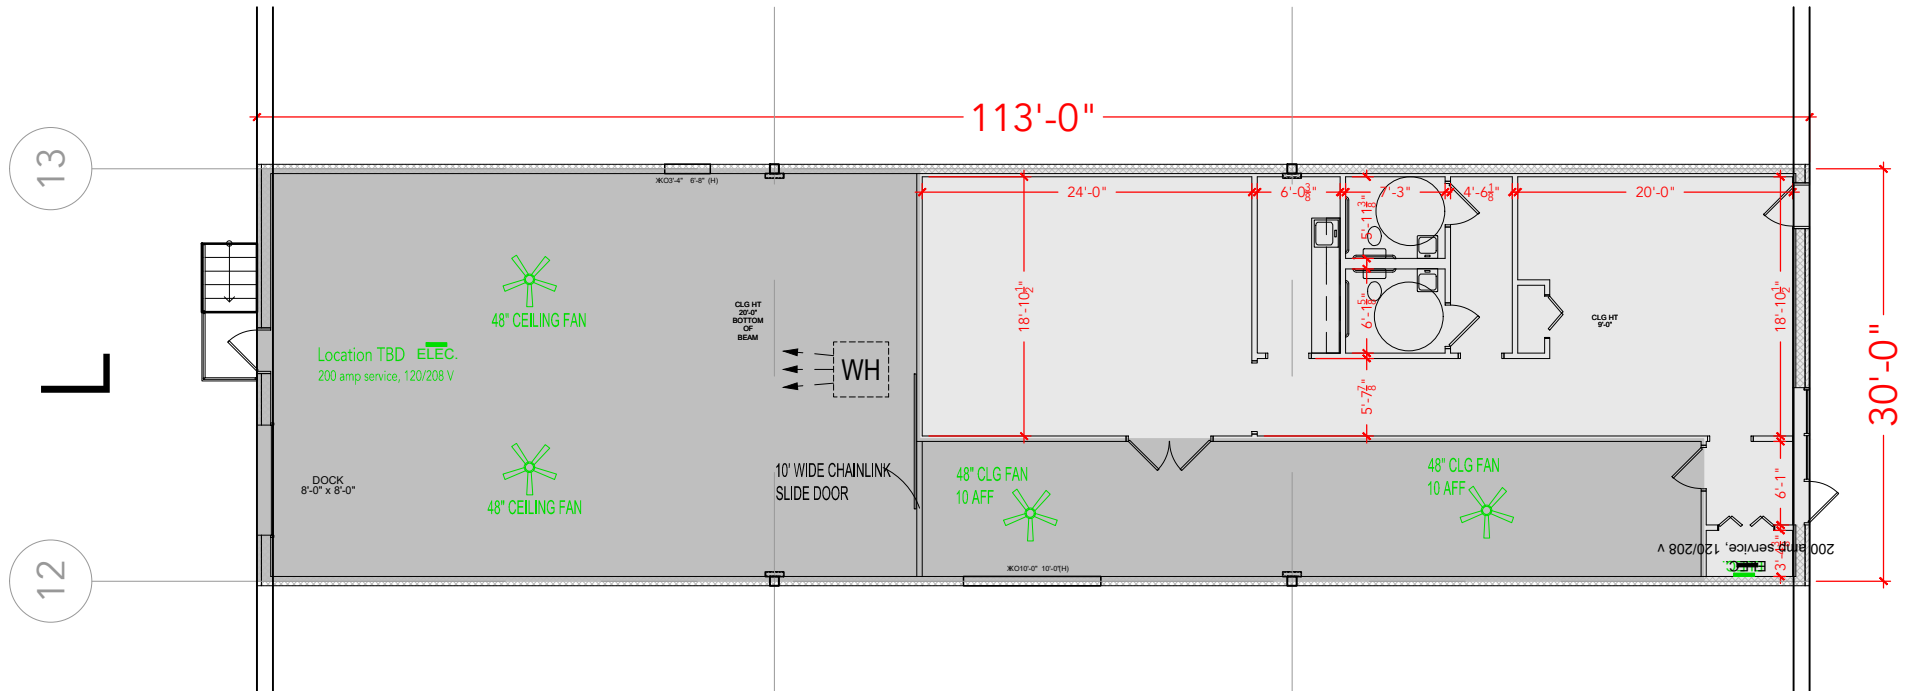

Floor Plan