

TOTAL SF AVAILABLE - 4,200 SF

OFFICE - 0,000 SF

WAREHOUSE - 4,200 SF

[Click to access 3D model](#)



Key Plan


SUITE 3325
1,035 TOTAL SQFT

SUITE 3323
1,035 TOTAL SQFT

SUITE 3321
1,050 TOTAL SQFT

SUITE 3319
1,080 TOTAL SQFT

GARAGE

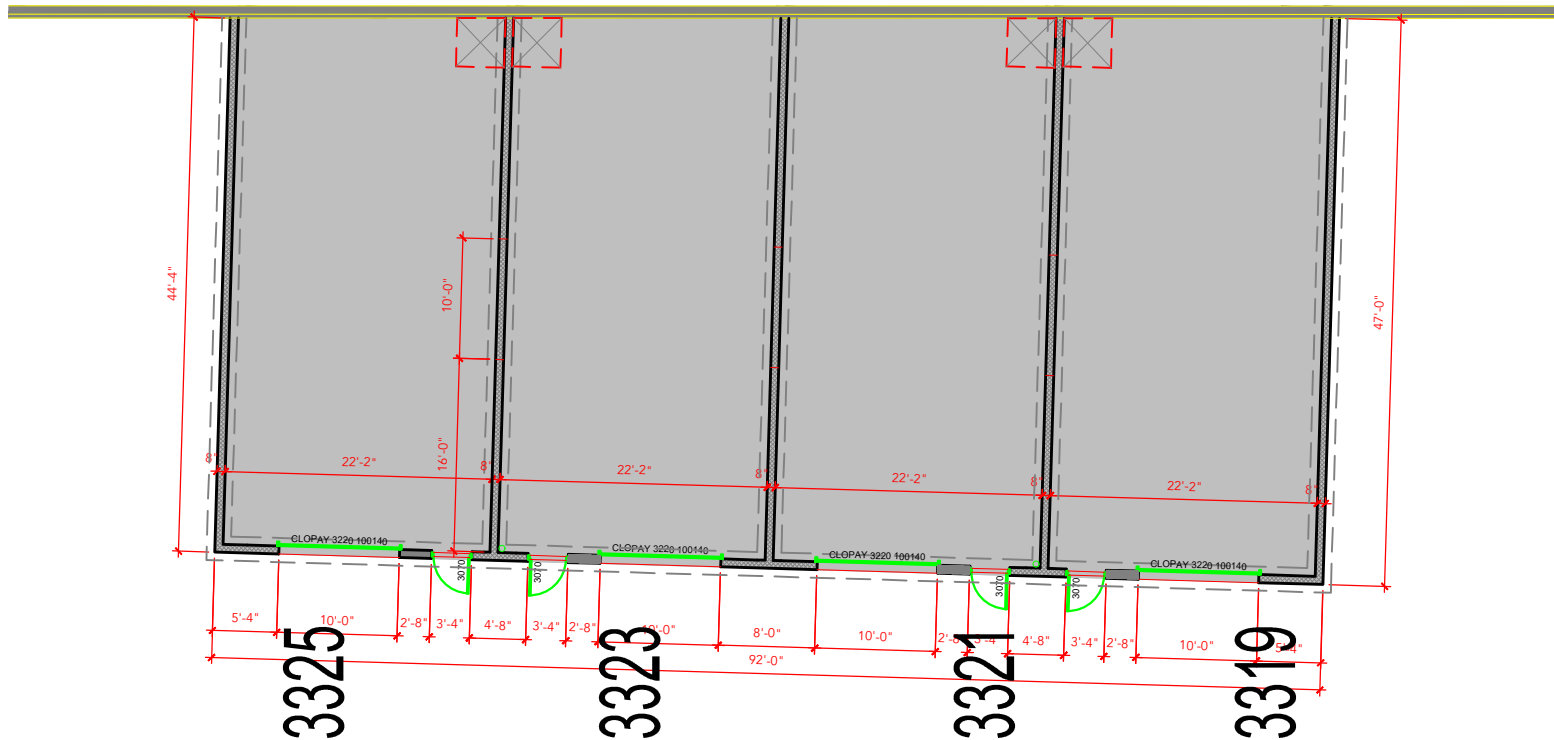

Floor Plan