


Key Plan

TOTAL SF AVAILABLE - 1,080 SF

OFFICE - 0,000 SF

WAREHOUSE - 1,080 SF

[Click to access CADD file](#)

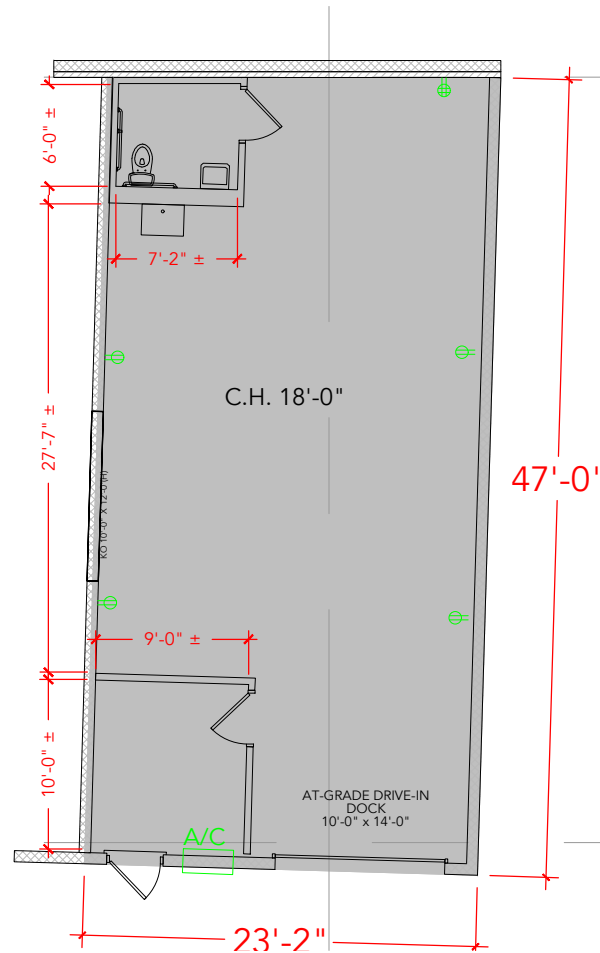

Floor Plan