


Key Plan

TOTAL SF AVAILABLE -1,035 SF

OFFICE - 0,000 SF

WAREHOUSE - 1,035 SF

[Click to access CADD file](#)

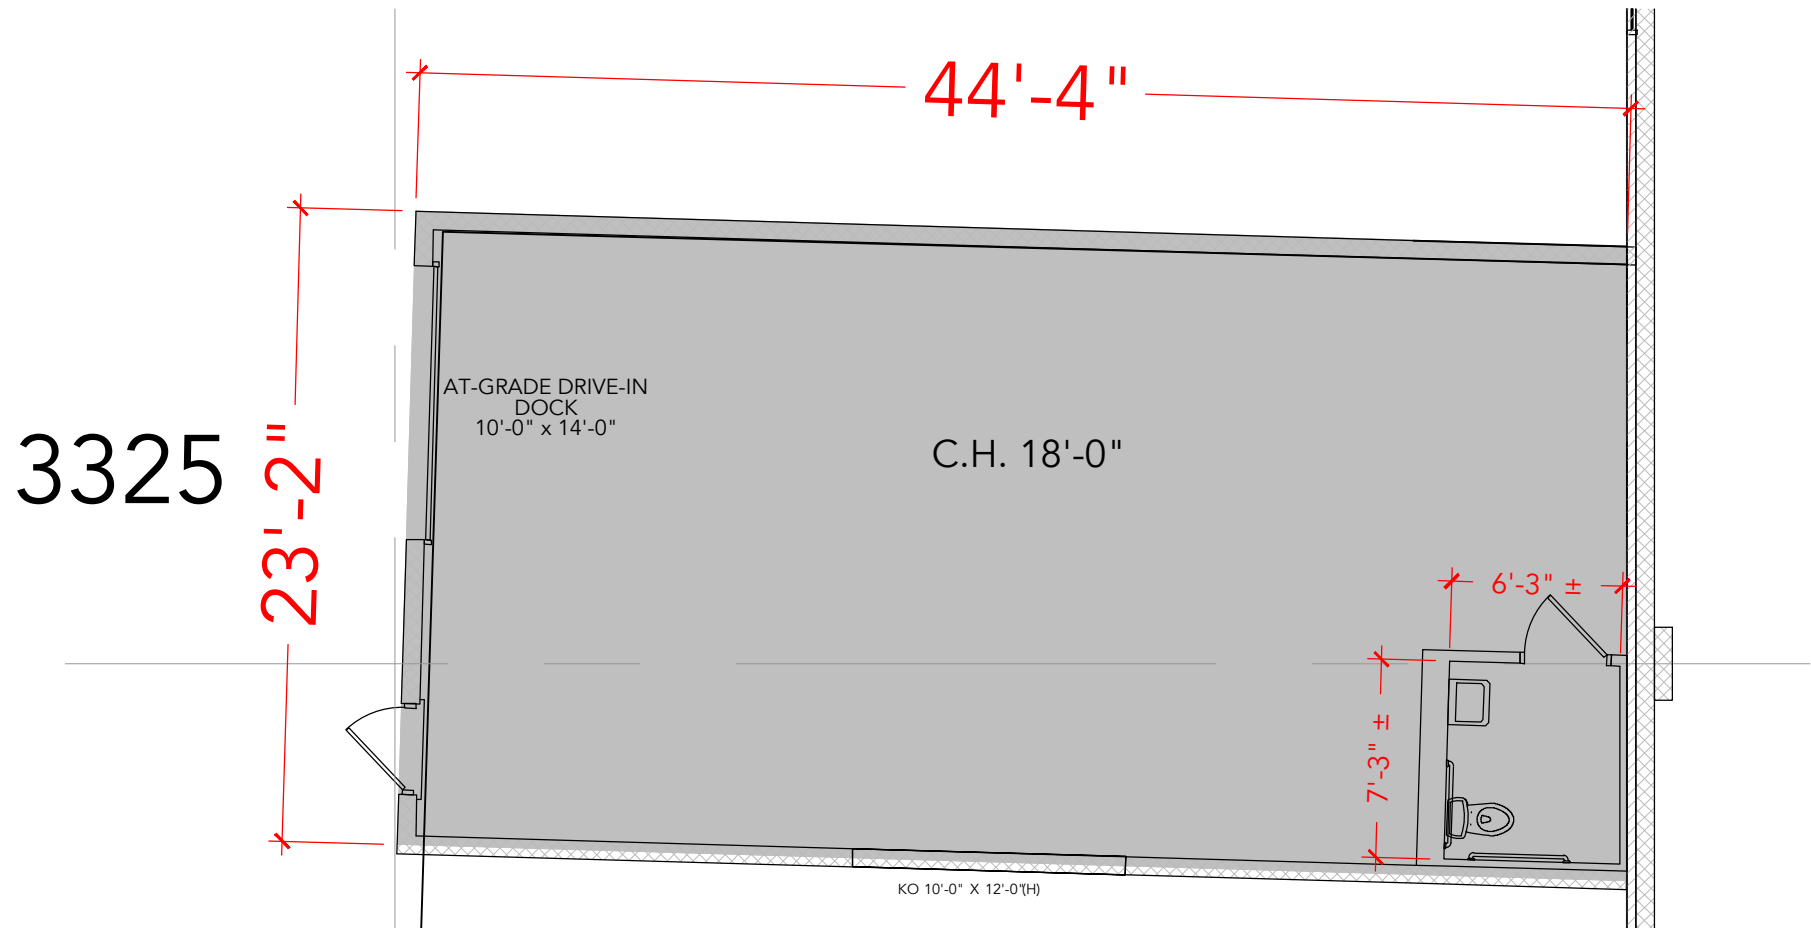

Floor Plan