



**TOTAL SF AVAILABLE -12,000 SF**

OFFICE - 0,000 SF  
WAREHOUSE - 12,000 SF

[Click to access CADD file](#)

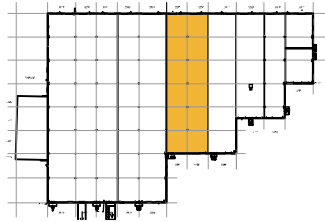

Key Plan

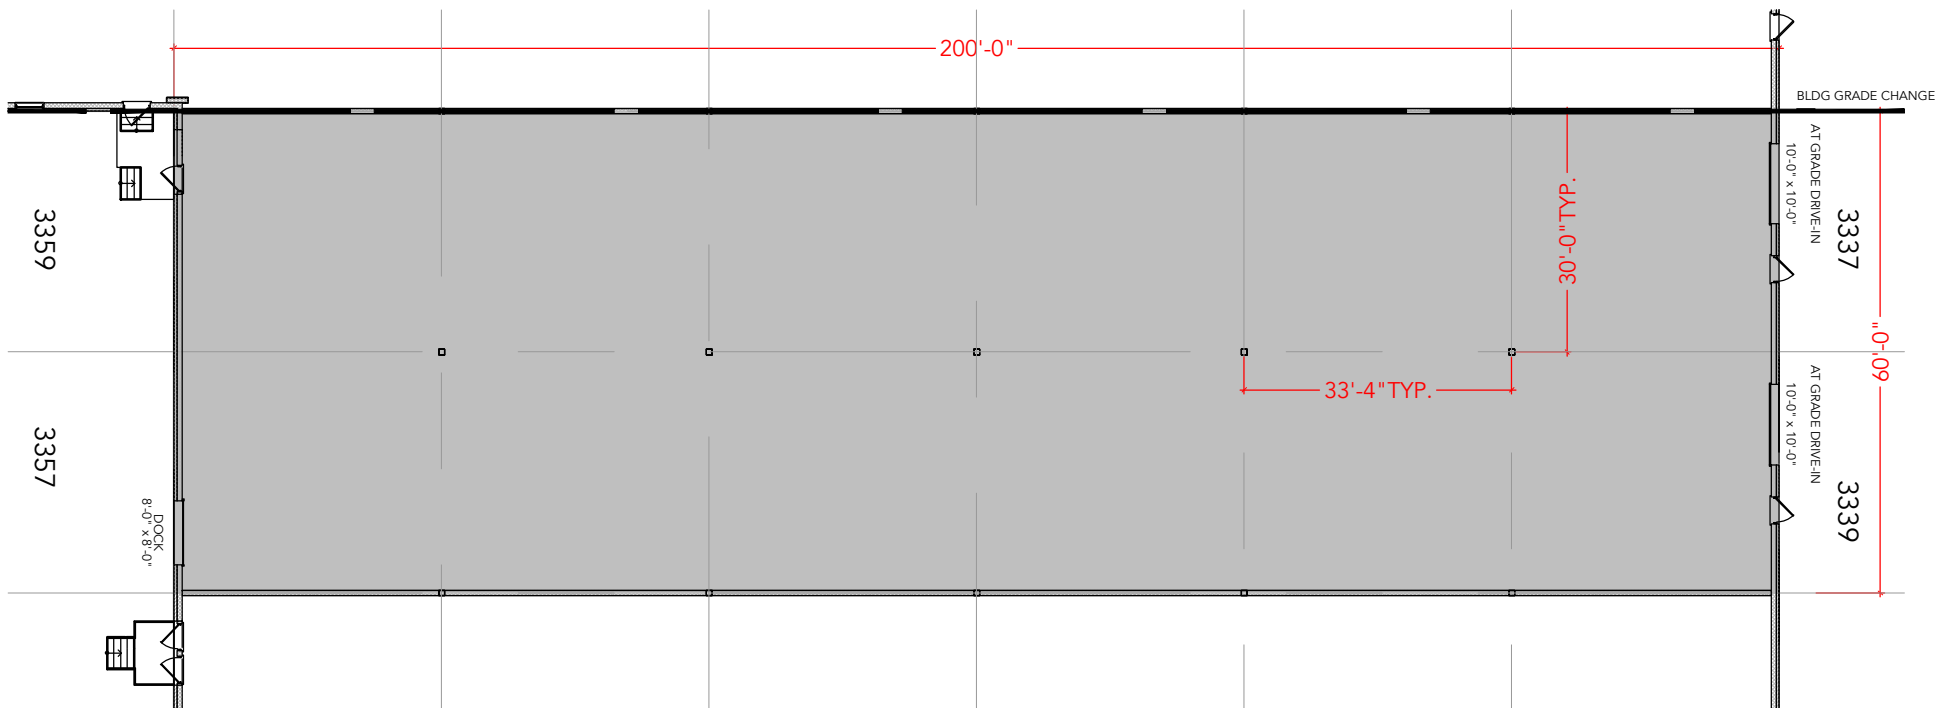

## Floor Plan