


TOTAL SF AVAILABLE - 21,674 SF


OFFICE - 738 SF

WAREHOUSE SF - 20,936 SF

[Click to access 3D model](#)

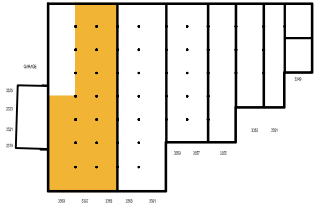

Key Plan

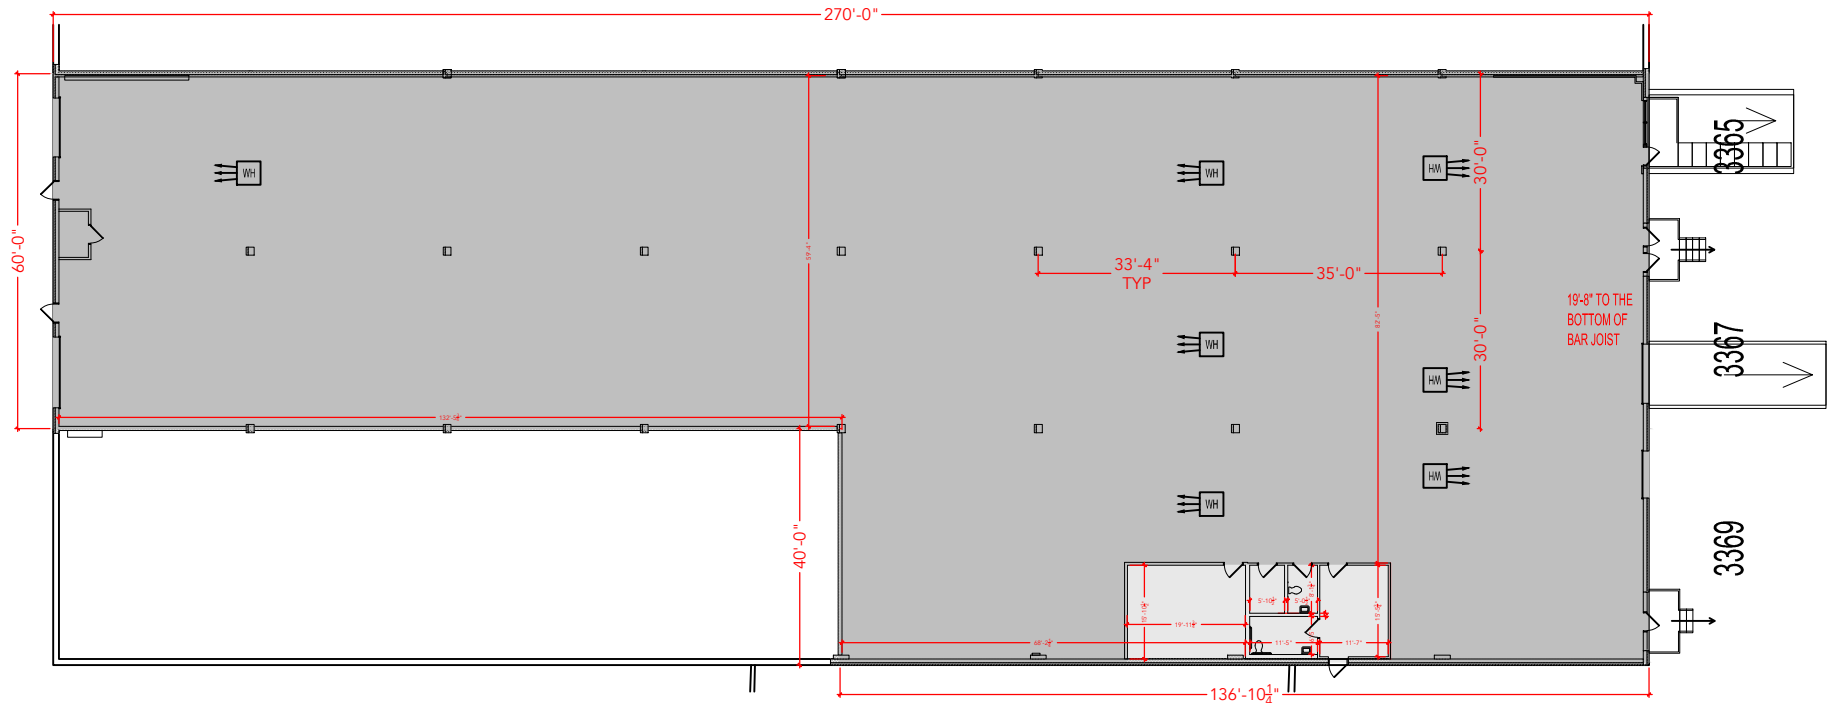

Floor Plan