


Key Plan

**TOTAL SF AVAILABLE - 6,000 SF**

OFFICE - 0,000 SF

WAREHOUSE - 6,000 SF

[Click to access CADD file](#)

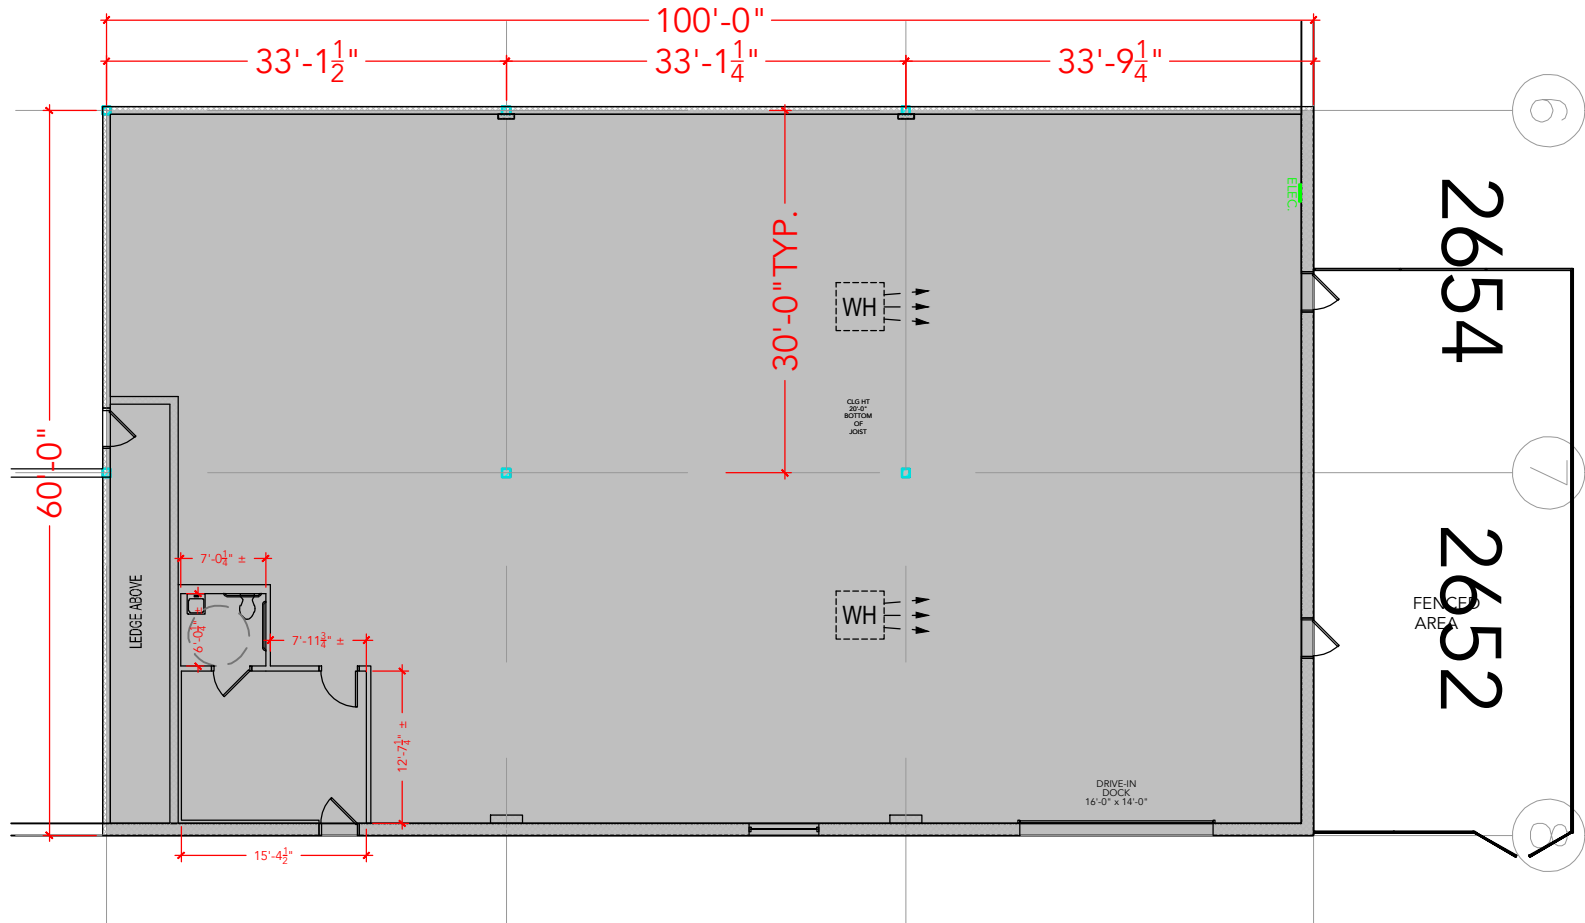

Floor Plan