


Key Plan

TOTAL SF AVAILABLE -7,000 SF

OFFICE - 388 SF

WAREHOUSE SF - 6,612 SF

[Click to access 3D model](#)

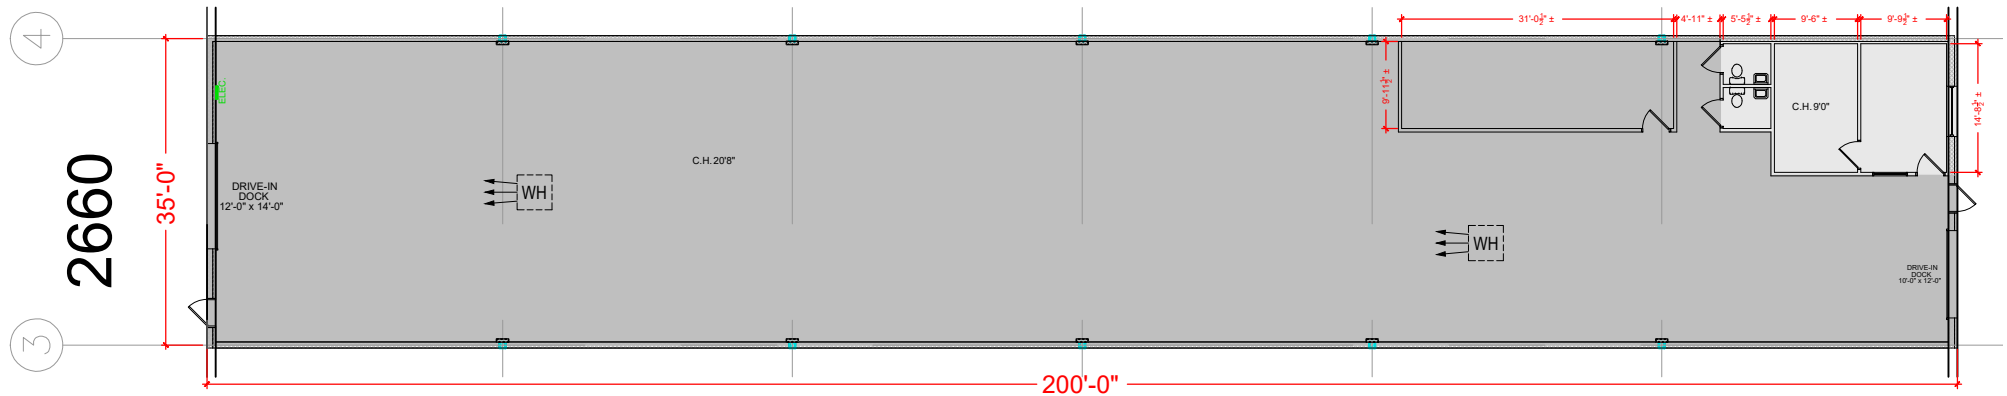

Floor Plan