


Key Plan

TOTAL SF AVAILABLE - 17,000 SF

OFFICE - 727 SF

WAREHOUSE - 16,273 SF

[Click to access CADD file](#)

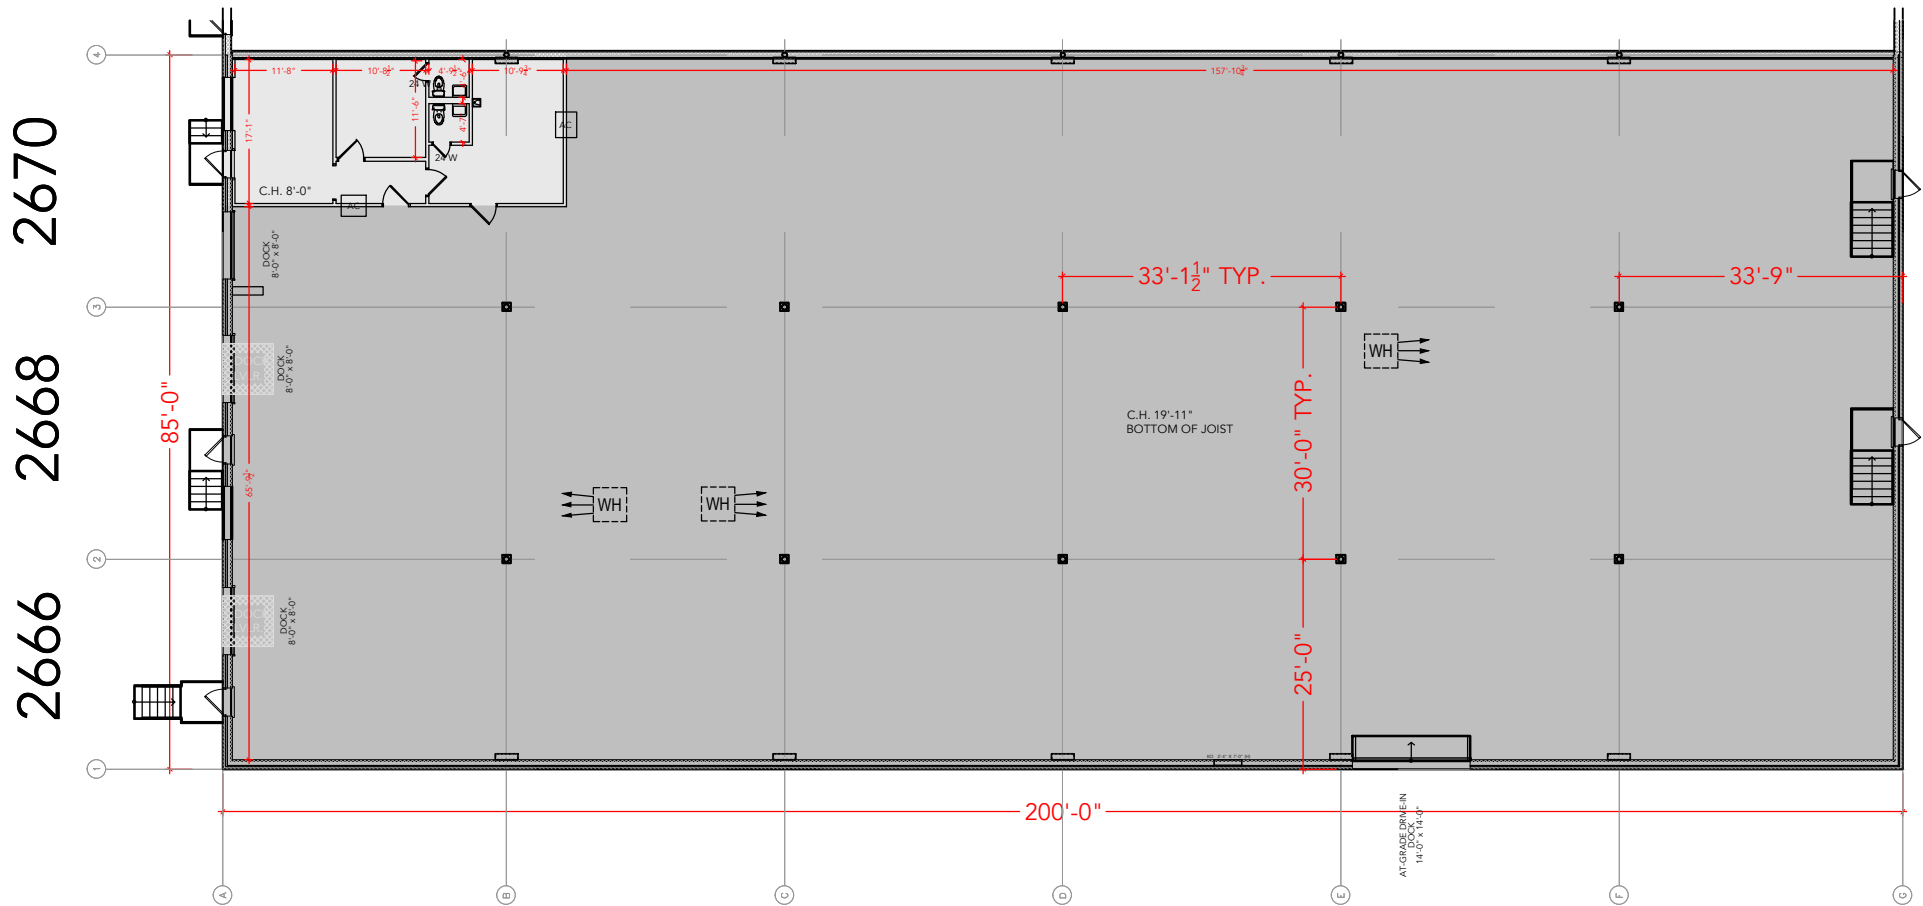

Floor Plan