


Key Plan

TOTAL SF AVAILABLE - 18,000 SF

OFFICE - 2,013 SF
WAREHOUSE - 15,987 SF

[Click to access 3D model](#)

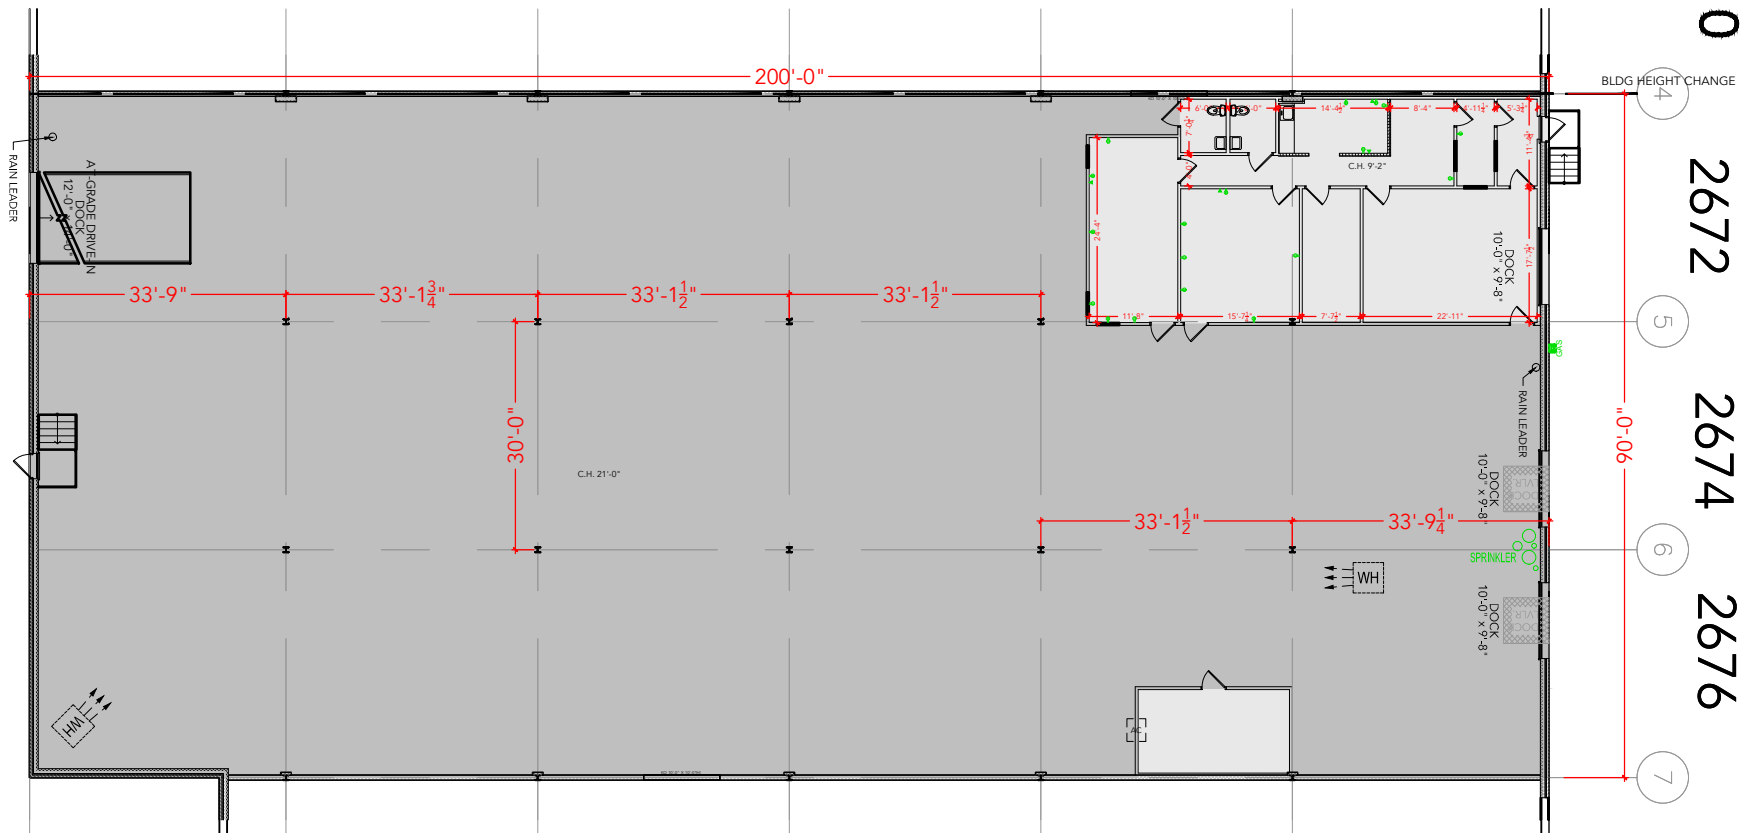

Floor Plan