


TOTAL SF AVAILABLE -18,000 SF

OFFICE - 1,333 SF

WAREHOUSE - 16,667 SF

[Click to access CADD file](#)

Key Plan

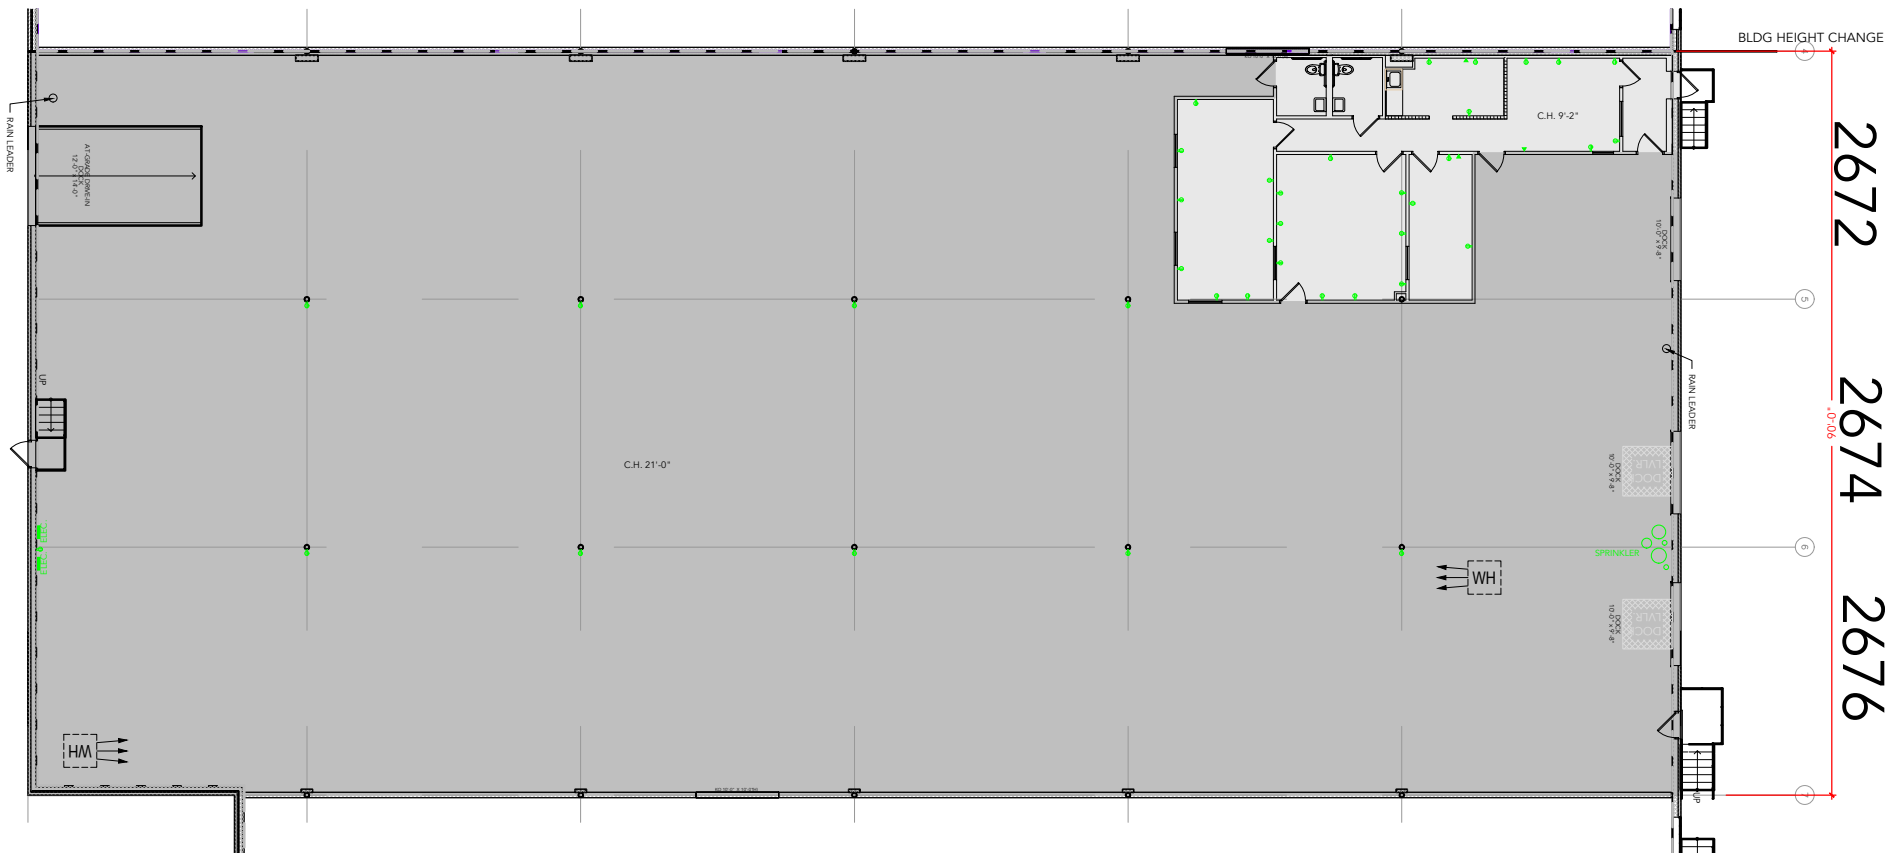

Floor Plan