


Key Plan

TOTAL SF AVAILABLE - 4,500 SF

OFFICE - 1,000 SF

WAREHOUSE - 3,500 SF

[Click to access 3D model](#)

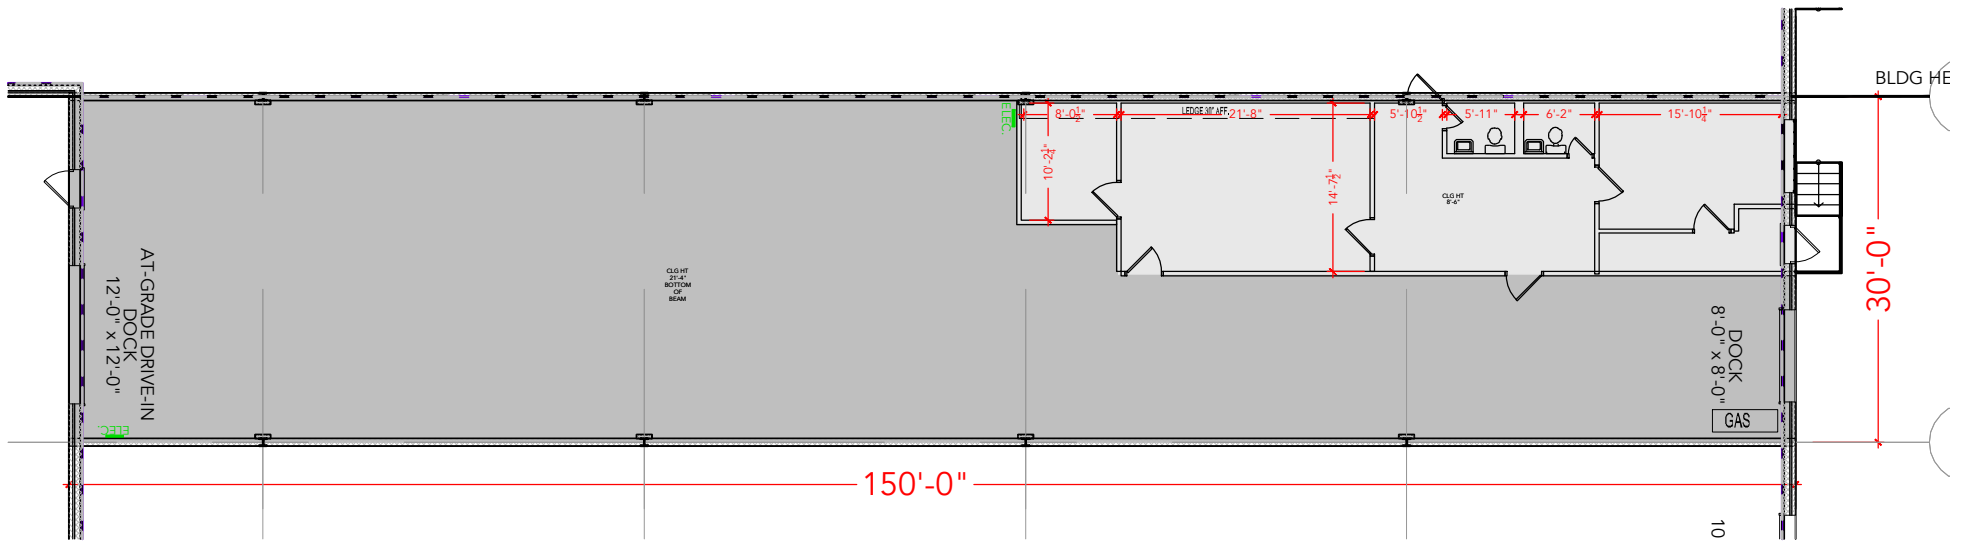

Floor Plan