




Key Plan

TOTAL SF AVAILABLE -6,048 SF

OFFICE - 281 SF

WAREHOUSE - 5,767 SF

[Click to access CADD file](#)

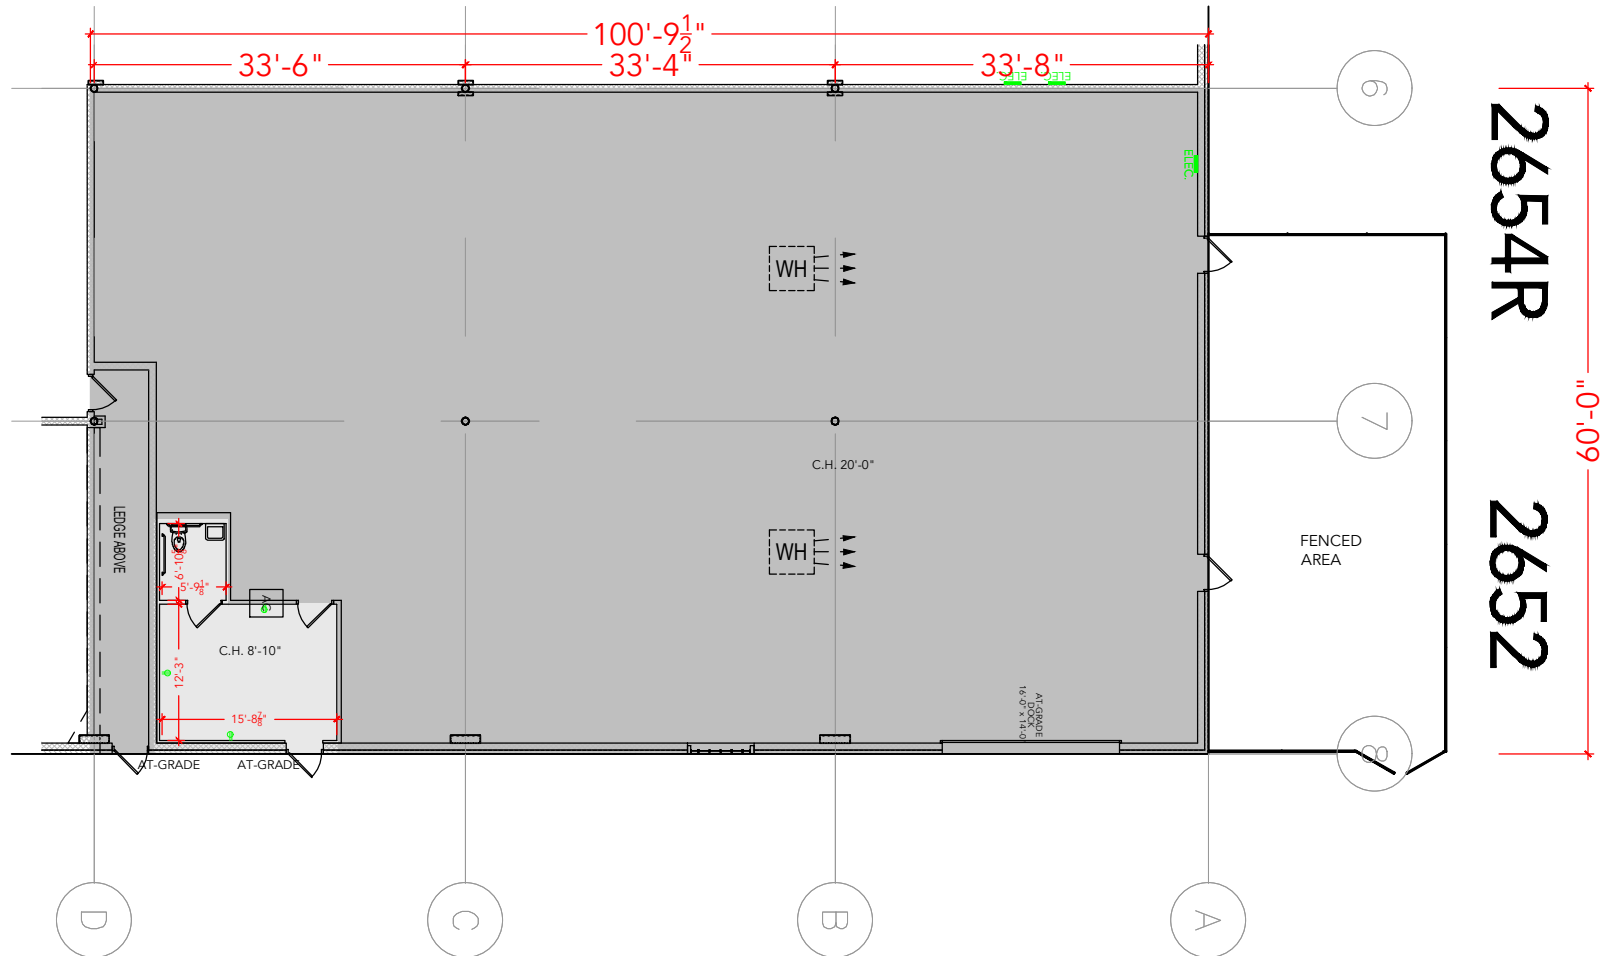

Floor Plan