


TOTAL SF AVAILABLE - 3,300 SF

OFFICE - 705 SF


WAREHOUSE SF - 2,595 SF

[Click to access 3D model](#)

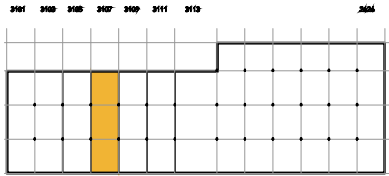

LOADING

Key Plan

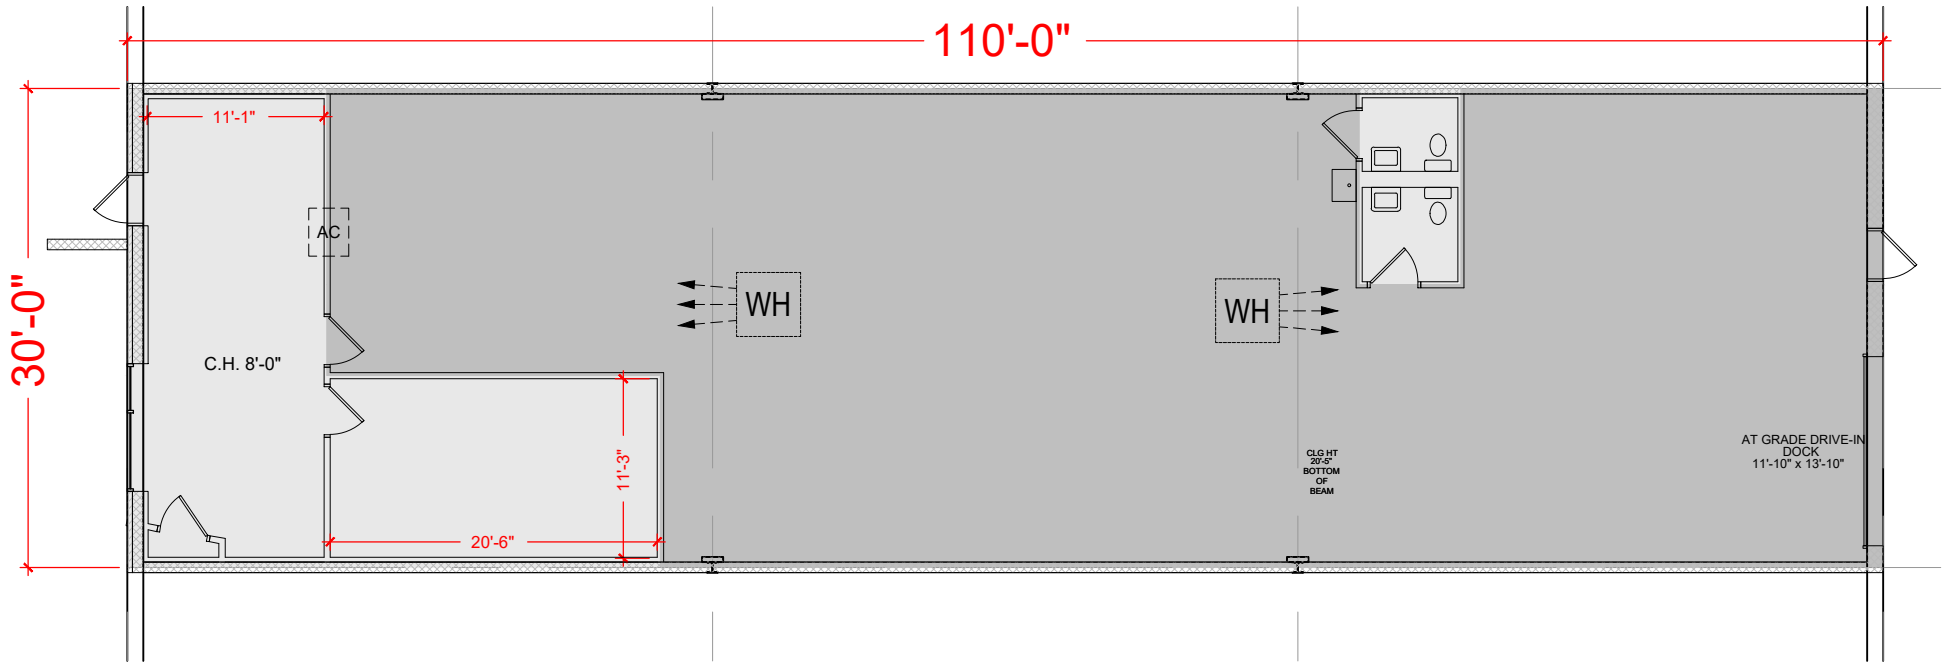

Floor Plan