


**TOTAL SF AVAILABLE - 3,300 SF**


**OFFICE - 0,000 SF**

**WAREHOUSE - 3,300 SF**

[Click to access 3D model](#)

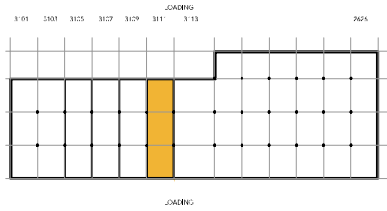

Key Plan

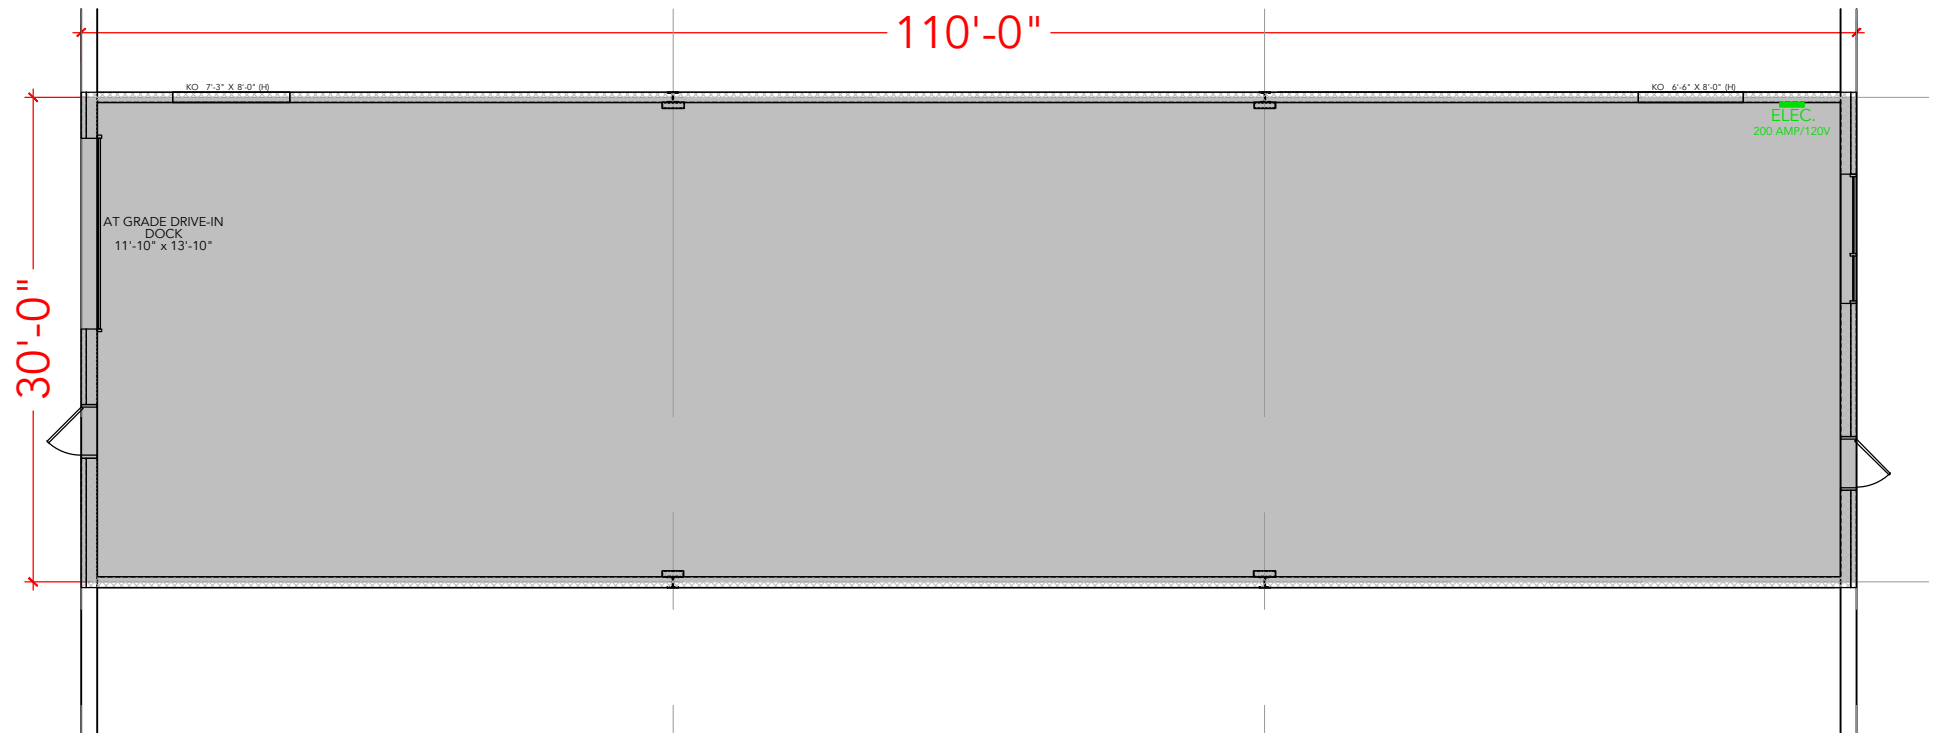

## Floor Plan