


Key Plan

TOTAL SF AVAILABLE - 5,105 SF

OFFICE - 248 SF

WAREHOUSE - 4,857 SF

[Click to access 3D model](#)

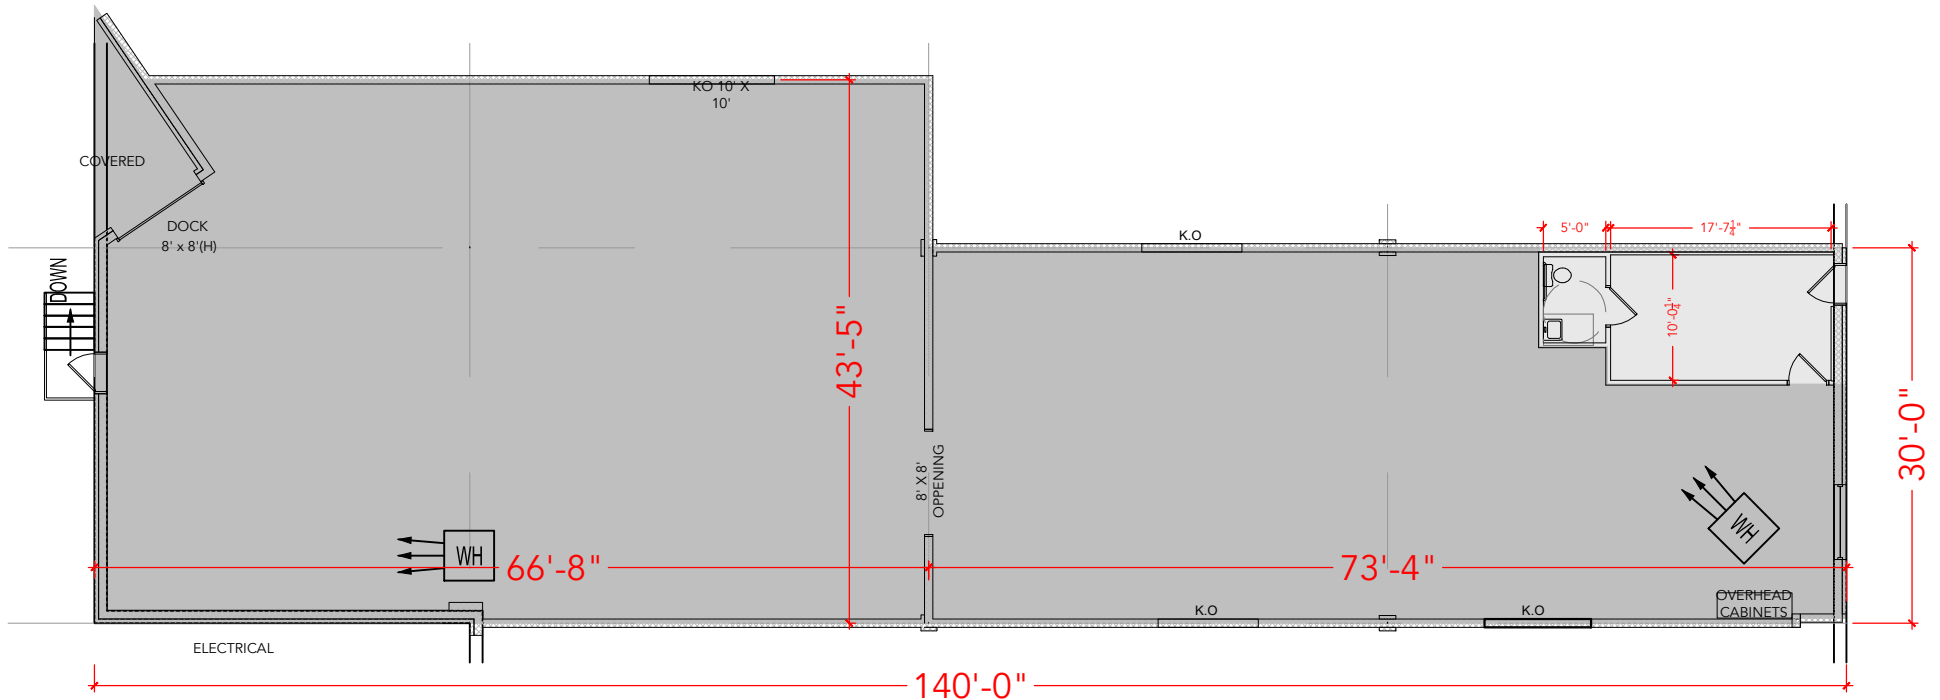

Floor Plan