


TOTAL SF AVAILABLE -1,802 RSF

OFFICE - 1,802 RSF


WAREHOUSE - 0,0000 RSF

* INCLUDES % OF METER ROOM

[Click to access 3D model](#)

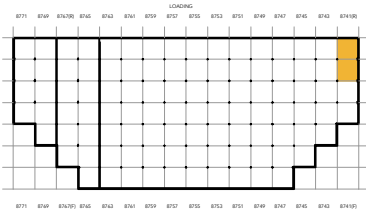

Key Plan

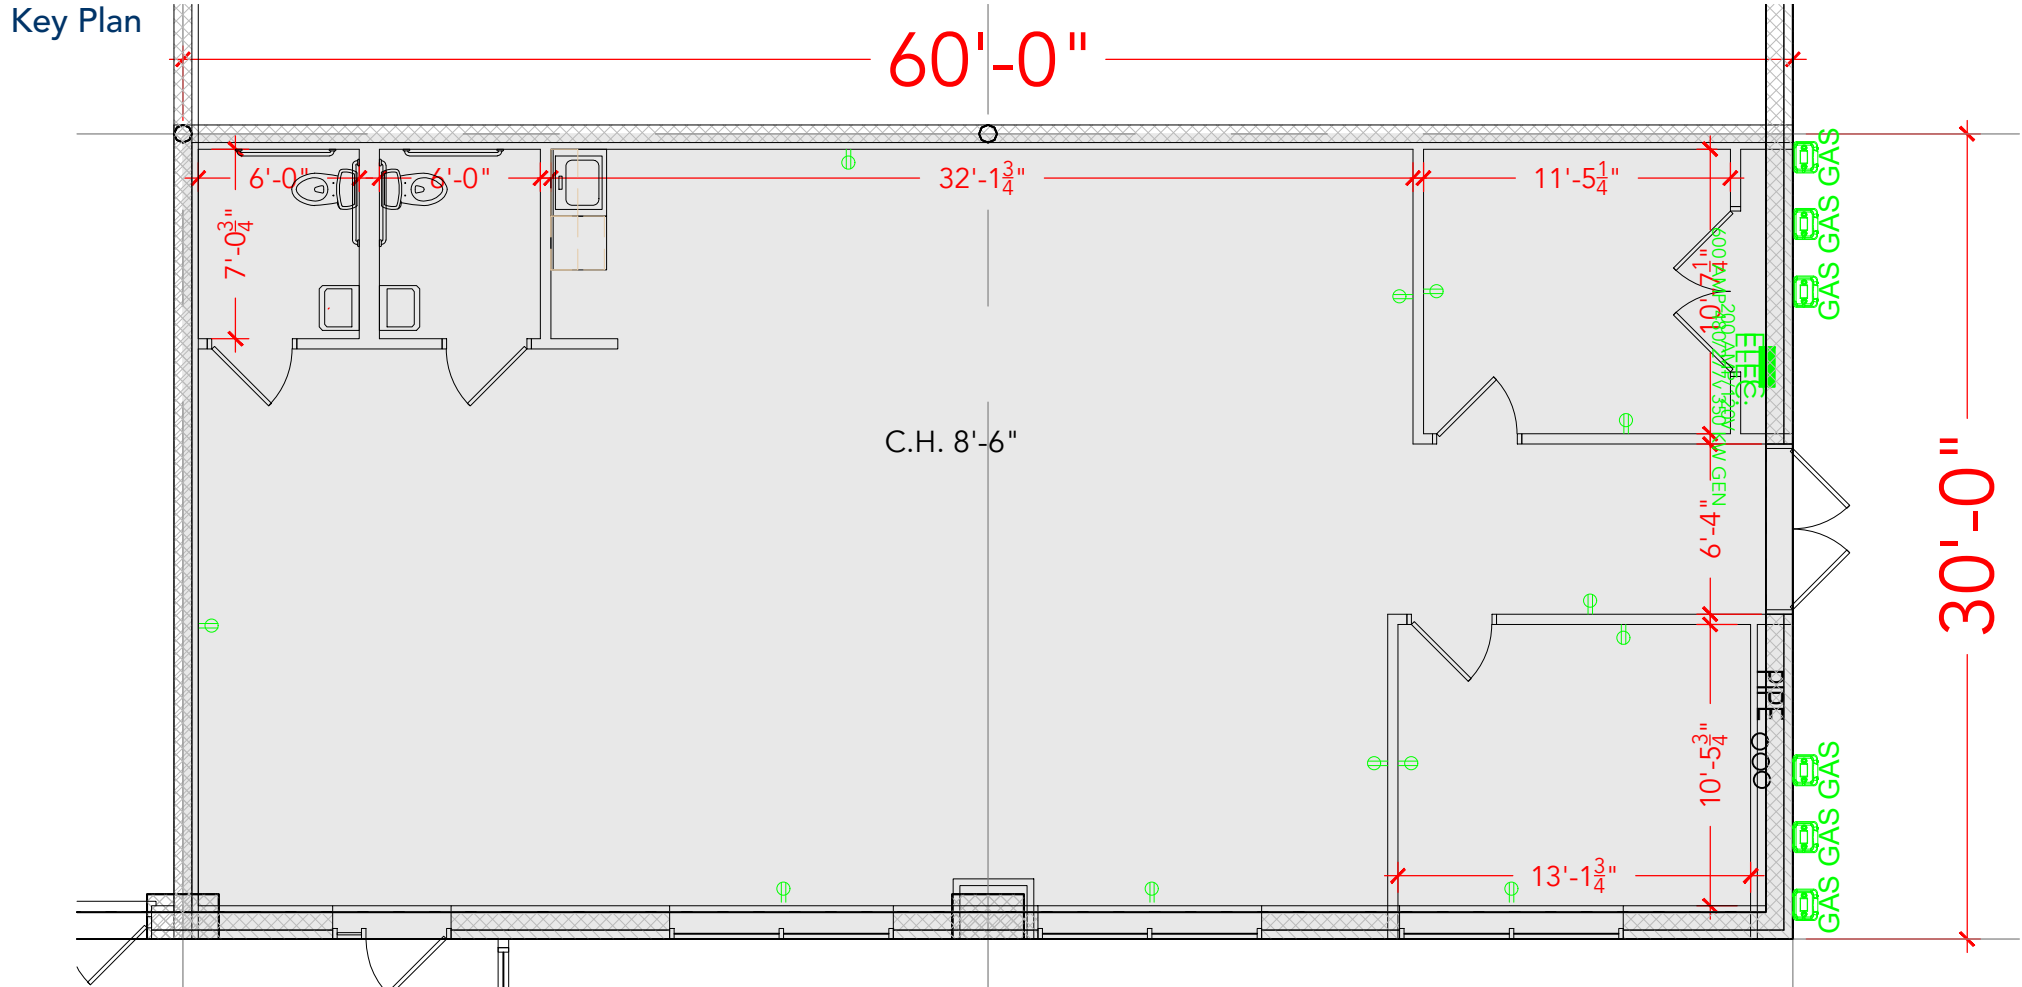

Floor Plan