


TOTAL SF AVAILABLE -8,917 RSF

OFFICE - 831 RSF


WAREHOUSE - 8,086 RSF

* INCLUDES % OF METER ROOM

[Click to access CADD file](#)

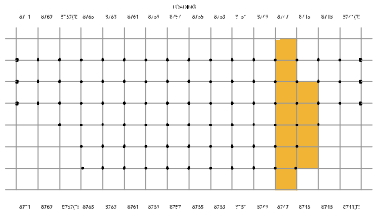

Key Plan

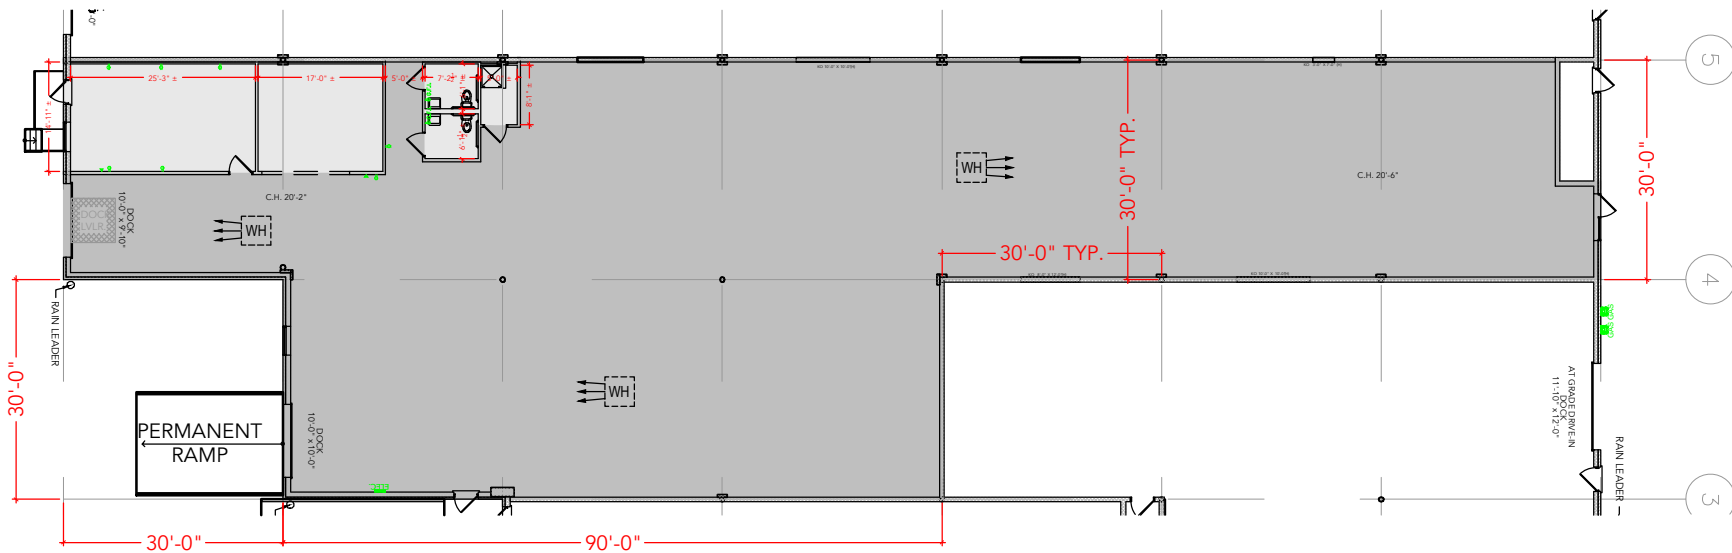

Floor Plan