


TOTAL SF AVAILABLE -12,612 RSF

OFFICE - 3,378 RSF


WAREHOUSE - 9,234 RSF

* INCLUDES % OF METER ROOM

[Click to access CADD file](#)

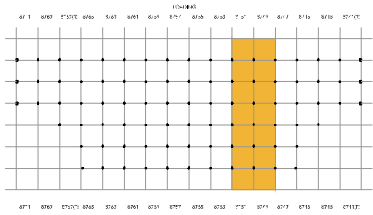

Key Plan

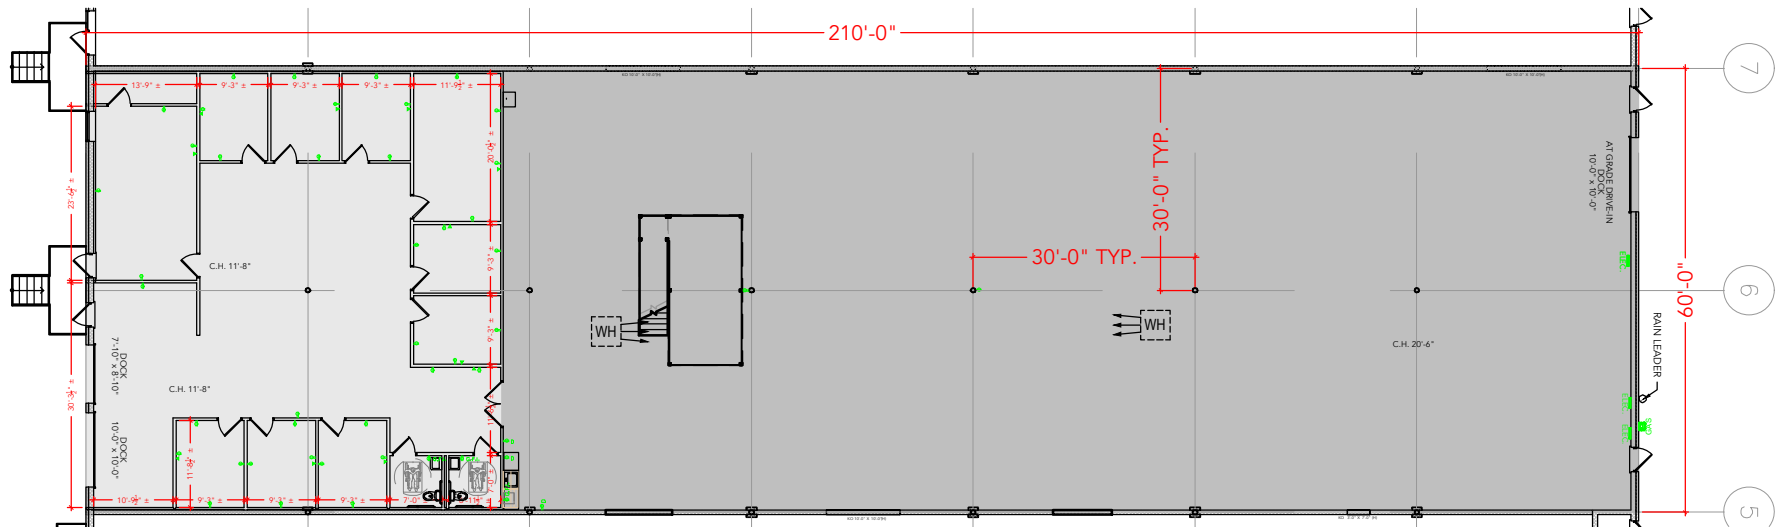

8751
8749

Floor Plan