


**TOTAL SF AVAILABLE -9,009 RSF**

**OFFICE - 0,000 RSF**


**WAREHOUSE - 9,009 RSF**

\* INCLUDES % OF METER ROOM

[Click to access CADD file](#)

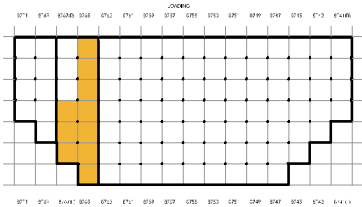

Key Plan

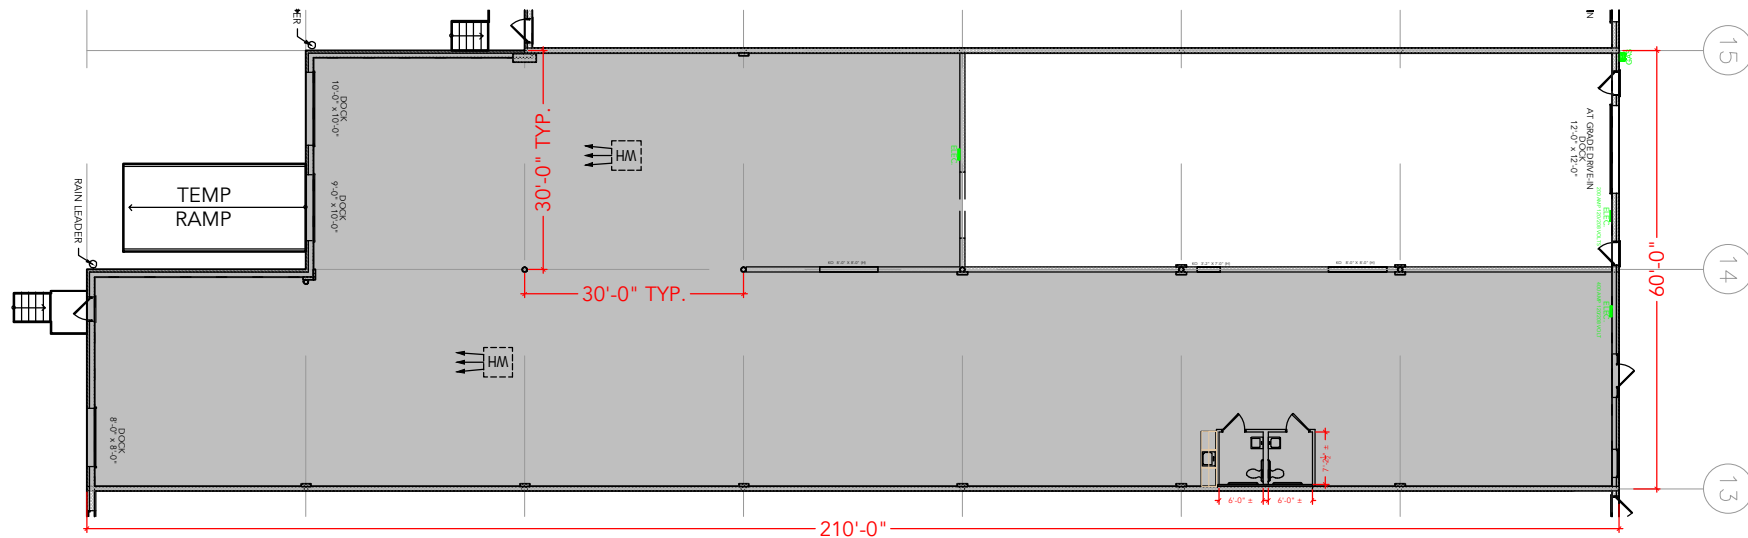

8767(R) 8765

## Floor Plan