


TOTAL SF AVAILABLE - 2,700 SF


OFFICE - 369 SF

WAREHOUSE SF - 2,331 SF

[Click to access 3D model](#)

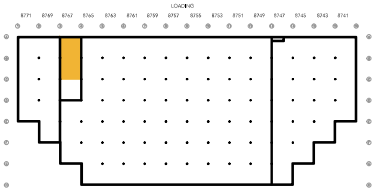

Key Plan

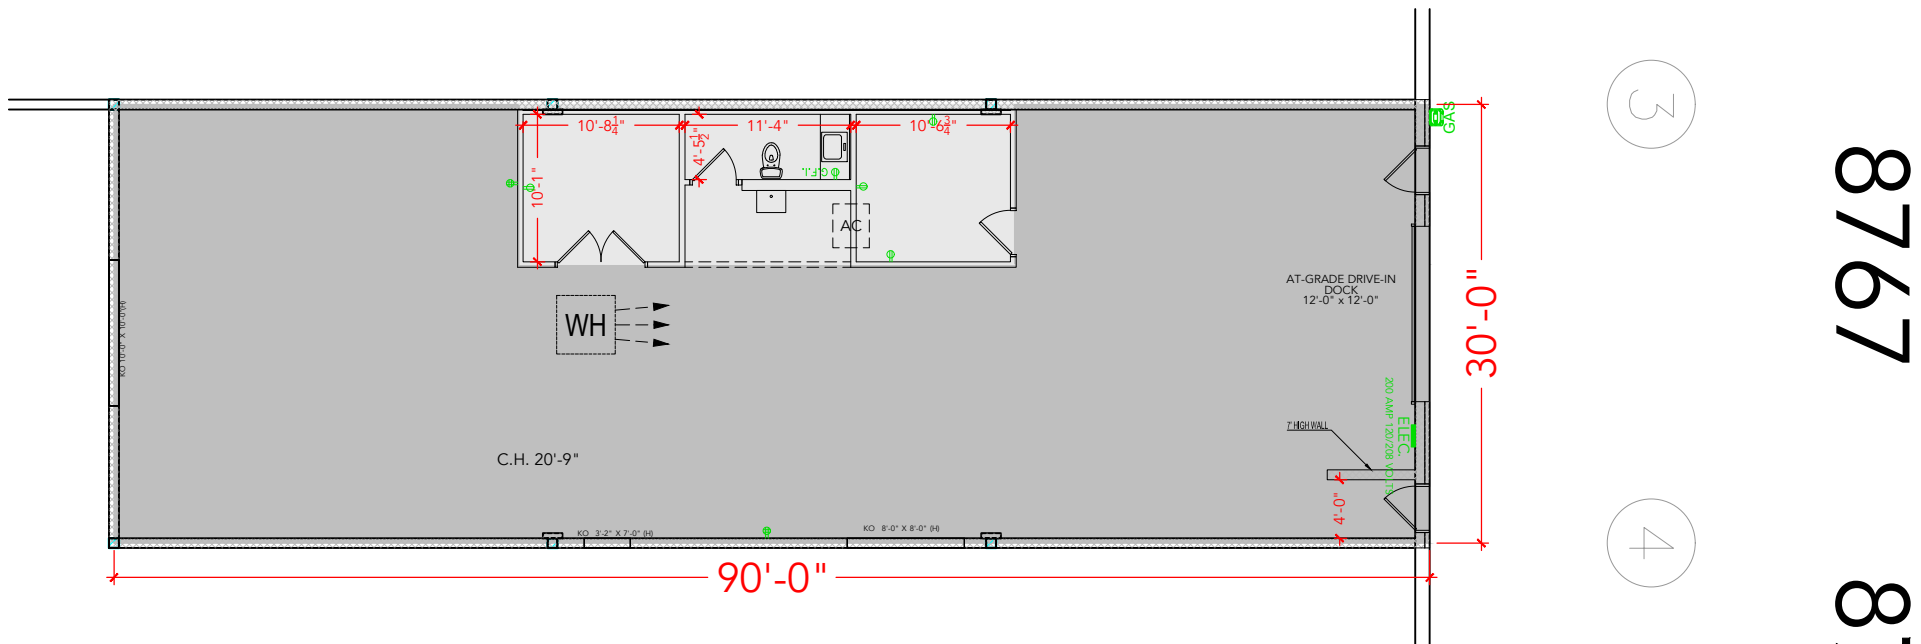

Floor Plan