


TOTAL SF AVAILABLE -2,703 RSF

OFFICE - 0,000 RSF


WAREHOUSE - 2,703 RSF

* INCLUDES % OF METER ROOM

[Click to access CADD file](#)

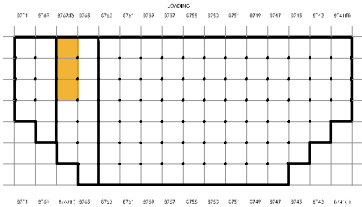

Key Plan

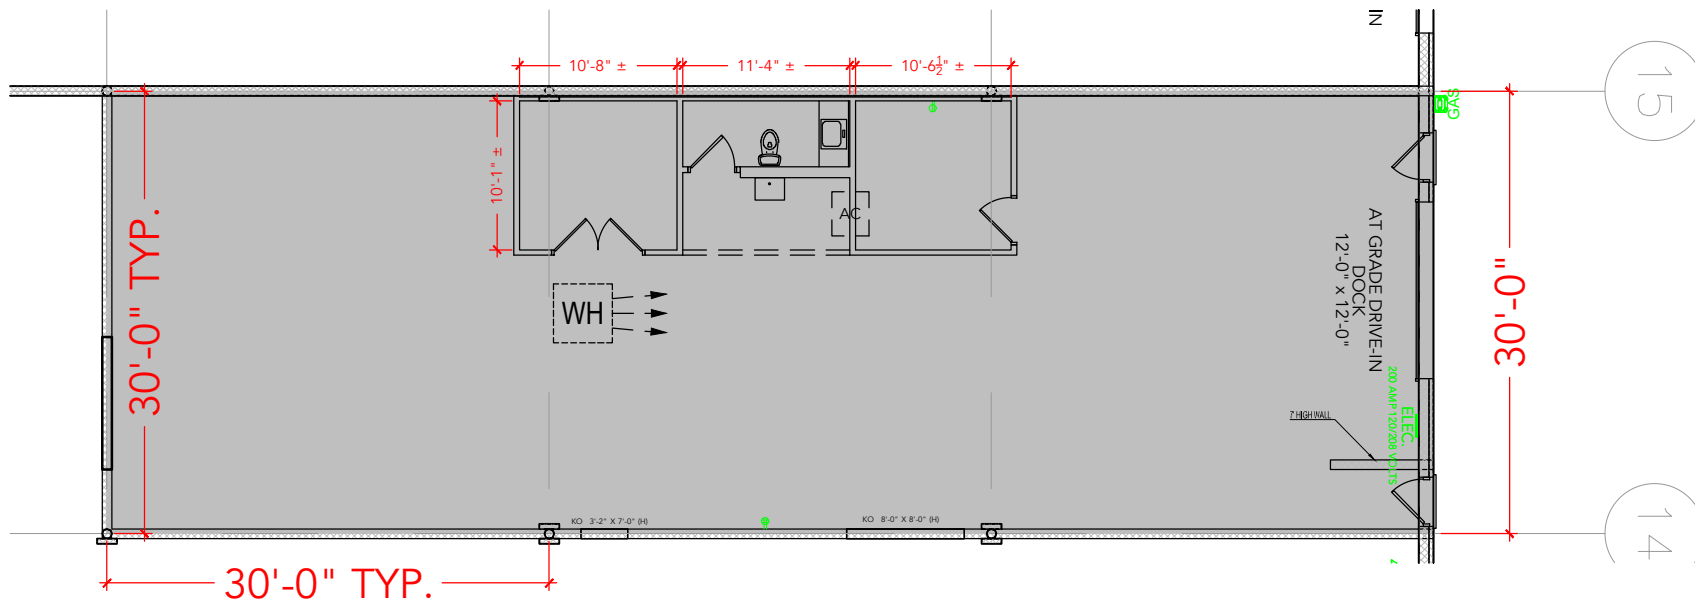

8767(R)

Floor Plan