



TOTAL SF AVAILABLE 3,874 RSF

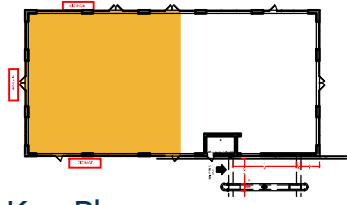

Key Plan

[Click to access 3D model](#)

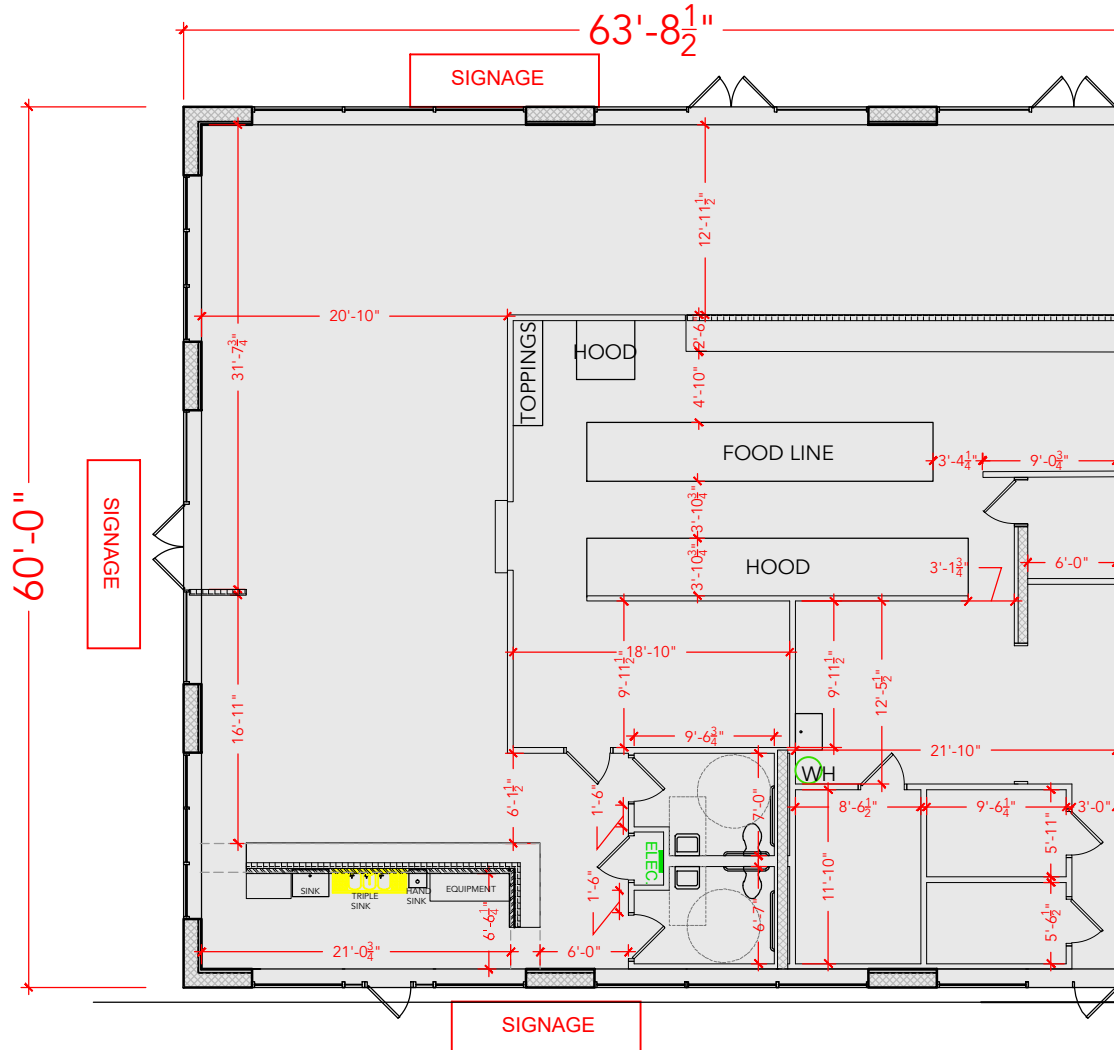

Floor Plan