



TOTAL SF AVAILABLE - 3,874 RSF

* MECH ROOM CORE FACTOR INCLUDED
[Click to access 3D model](#)

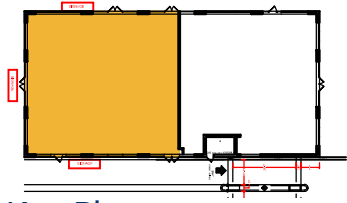

Key Plan

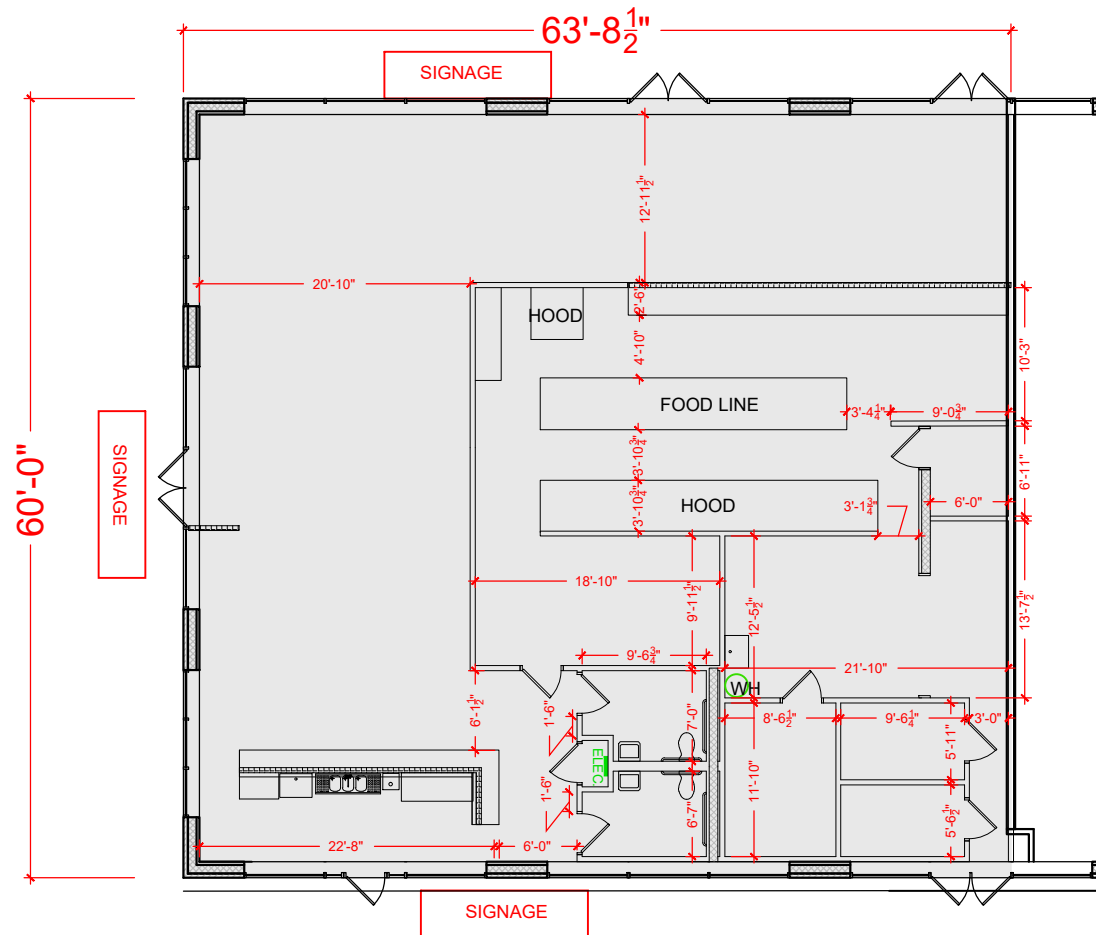

Floor Plan